

Note: Improvements on this lot are not in a flood hazard area.

FILED
GREENVILLE CO. S. C.
JAN 31 3 59 PM '86
DUNNIE STANKERSLEY
R.M.C.

EVEREST STREET
WATER & SEWER IN ST. R/W

PROPERTY OF
PEDRO ORLANDO MARTINO & LEONIDES M. MARTINO
NEAR GREENVILLE, S.C.
SCALE: 1"=40' 29 JAN 1986




This is to certify that on the 29th day of January, 1986, I surveyed the property shown on this plat, being known as part of lot 16 on plat of GREEN FOREST SECTION " B " and recorded in the RMC Office Greenville County, S. C., in Plat Book " KK " at Page 85 and also known as REVISION LOTS 11, 12, 15 & 16 SECTION " B " GREEN FOREST and recorded in Plat Book " UU " at Page 21 and also known as PROPERTY OF PEDRO ORLANDO MARTINO & LEONIDES M. MARTINO and recorded in Plat Book at Page ; and that the property lines, walls and buildings are as shown hereon, and that the walls and buildings located on said lot do not encroach or project on adjacent street or property, and that no adjacent walls or buildings encroach or project on said premises, and no power lines cross this property except as shown hereon.

12-I-73

JAN 31 1986

R. B. Bruce

R. B. Bruce, RLS # 1952

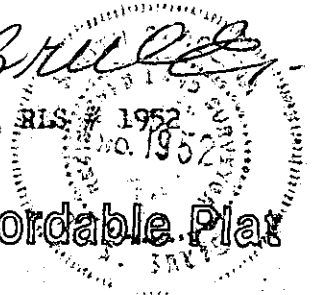

CAROLINA SURVEYING CO.
112 Manly St.
Greenville, S. C.

Recordable Plat

3.00001