


MICROFILMED

N/F WILTON HENDERSON

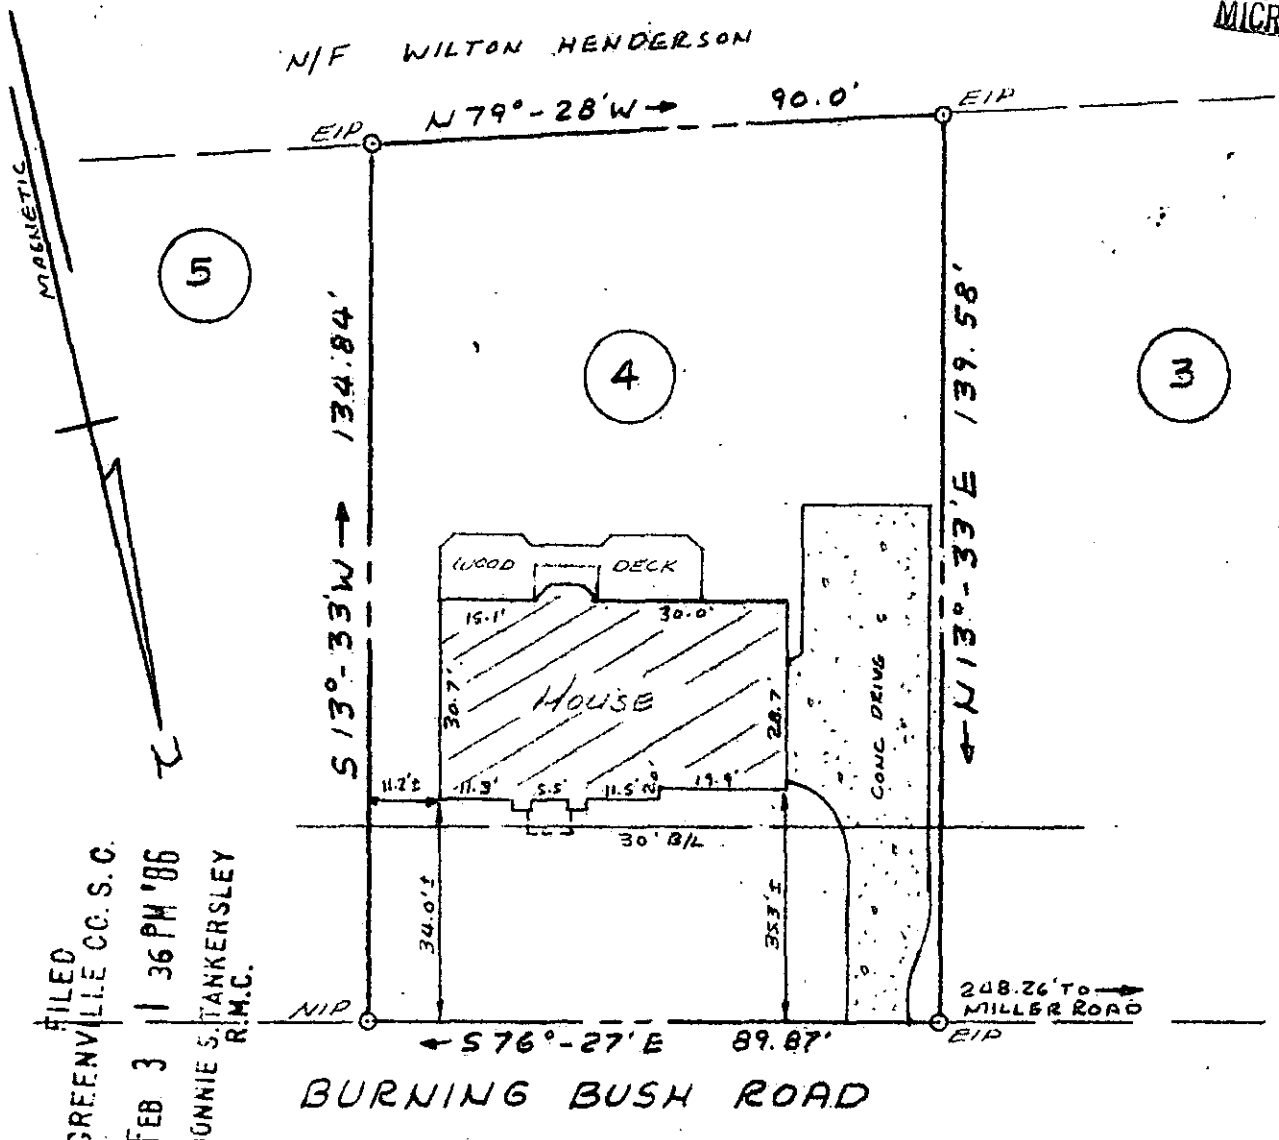

PROPERTY OF
ROBERT L. JACOBS &
LYNN K. JACOBS

GREENVILLE COUNTY, SOUTH CAR.
JANUARY 30, 1986 SCALE: 1" = 30'

RECORDABLE PLAT

12-I-86 25627

This is to certify that on January 30, 1986, I surveyed the property shown on this plat, known as Lot No. 4 of Forrester Farms as recorded in the RMC Office for Greenville County in Plat Book 10-M at Page 55, and that the property lines, walls and building are as shown hereon, and that the building located on said lot does not project nor encroach on adjacent streets or property, and that no adjacent walls or buildings project nor encroach on said lot. The degree of accuracy is 1/10,000.

NOTE: This property is not located within a flood hazard area.

Survey by: Richard D. Wooten, Jr.
 Greenville, South Carolina

5 foot drainage and utility easement along each side of all side and rear lot lines.

Richard D. Wooten, Jr.
 S. C. REG. L. S. No. 14698