


Note: Improvements on this lot are not in a flood hazard area.

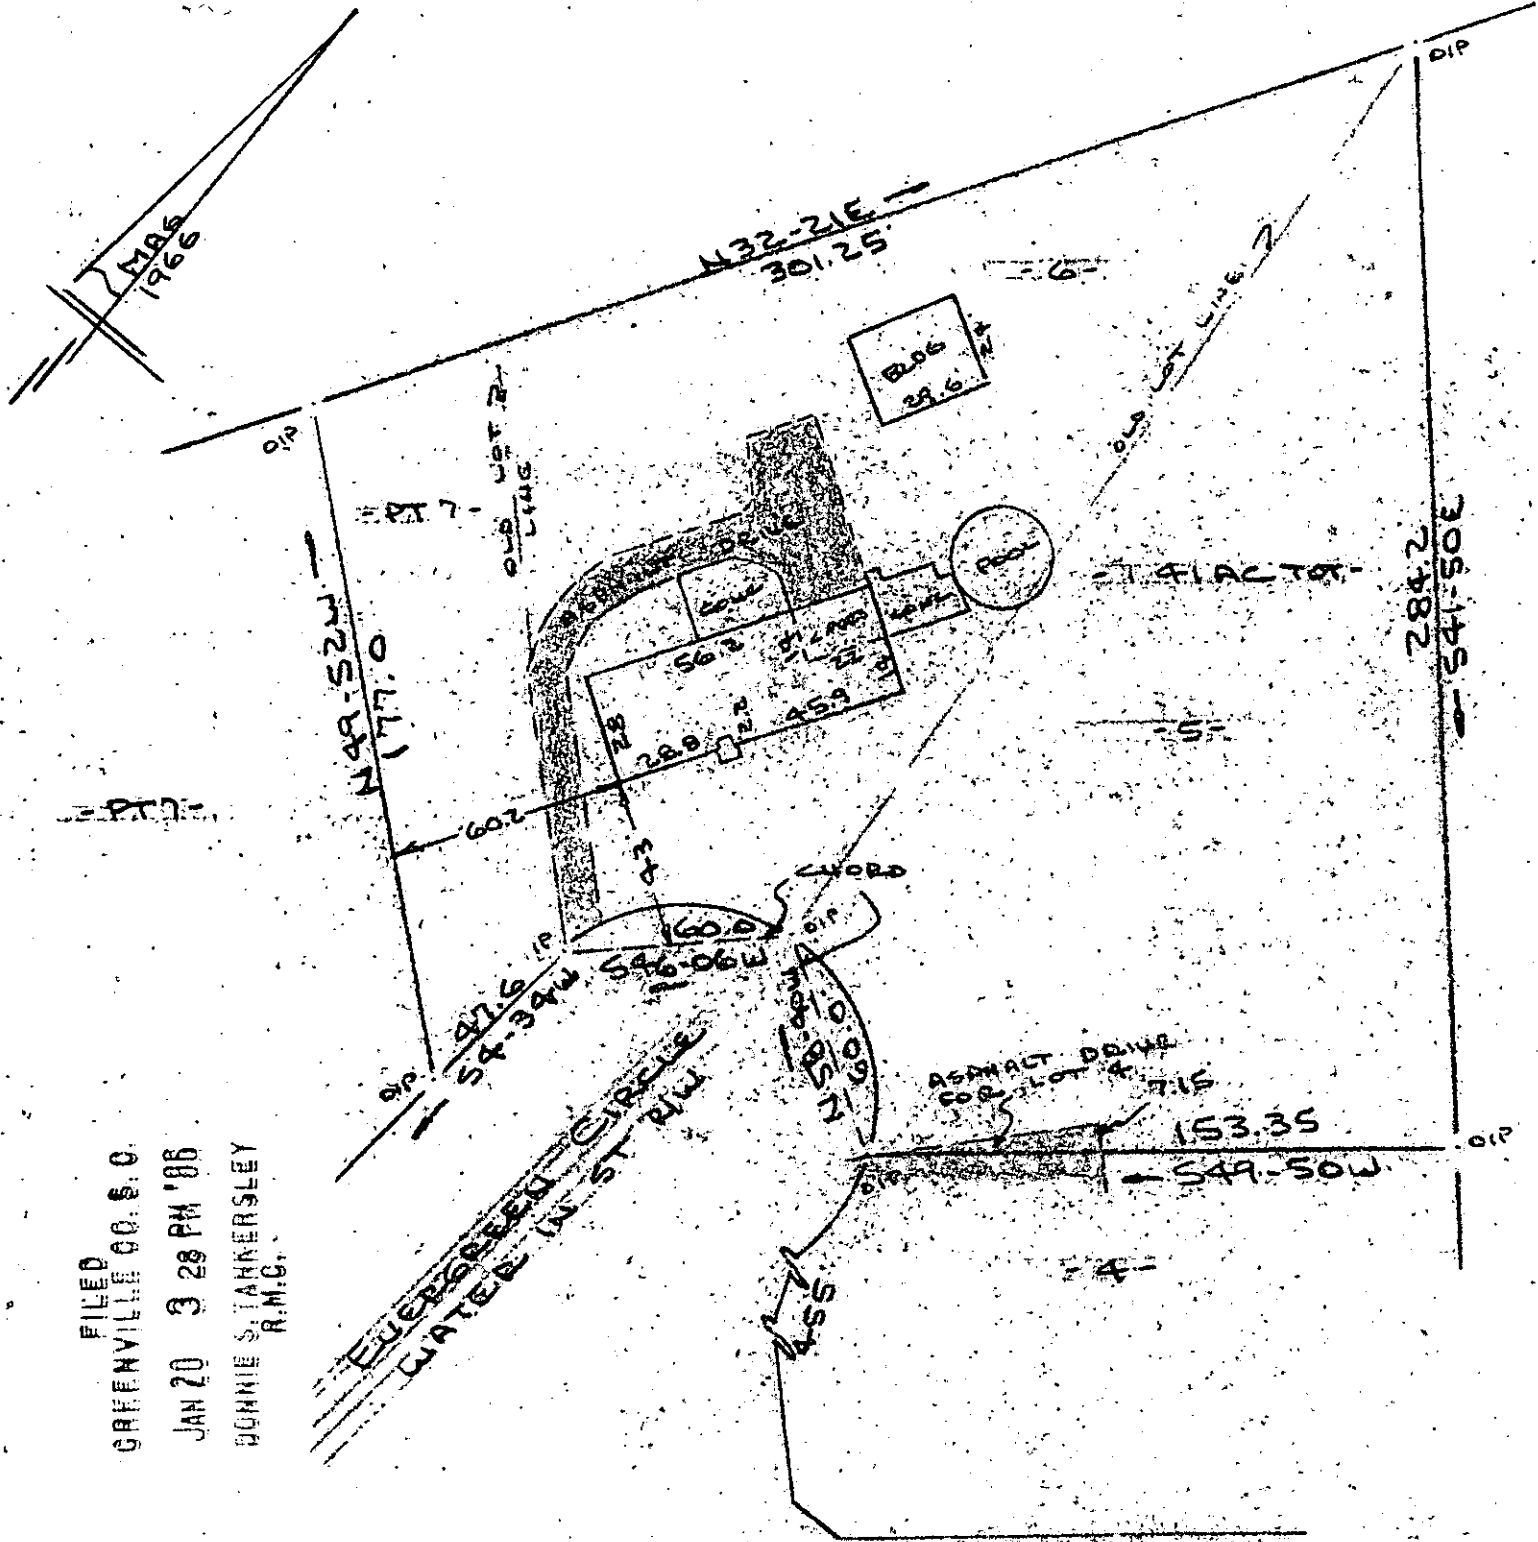

EARL T. BAUGHMAN

FILED
 GREENVILLE CO. S.C.
 JAN 20 3 28 PM '86
 BONNIE S. TARKERSLEY
 R.M.C.

BALCOMME BOULEVARD
 PROPERTY OF
 WADE H. SHEALY & CHARLIE L. THOMSON, JR.
 NEAR MAULDIN, GREENVILLE CO. S.C.
 SCALE: 1"=50' 20 JAN 1986



This is to certify that on the 20th day of January, 1986, I surveyed the property shown on this plat, being known as lot 5, 2nd 6 and part of lot 7 on plat of LAKEWOOD and recorded in the RMC Office Greenville County, S. C., in Plat Book "BBB" at Page 181 and also known as PROPERTY OF WADE H. SHEALY & CHARLIE L. THOMSON, JR. and recorded in Plat Book at Page ; and that the property lines, walls and buildings are as shown hereon, and that the walls and buildings located on said lot do not encroach or project on adjacent street or property, and that no adjacent walls or buildings encroach or project on said premises, and no power lines cross this property except as shown hereon.

12-J-7

23998

R. B. Bruce
 R. B. Bruce, RLS # 1952

JAN 20 1986

CAROLINA SURVEYING CO.
 112 Manly St.
 Greenville, S.C.

Recordable Plat

291-1-17 518