


FILED
GREENVILLE CO. S. C.
JAN 31 3 35 PM '86
DUNNIE S. TANKERSLEY
R.M.C.

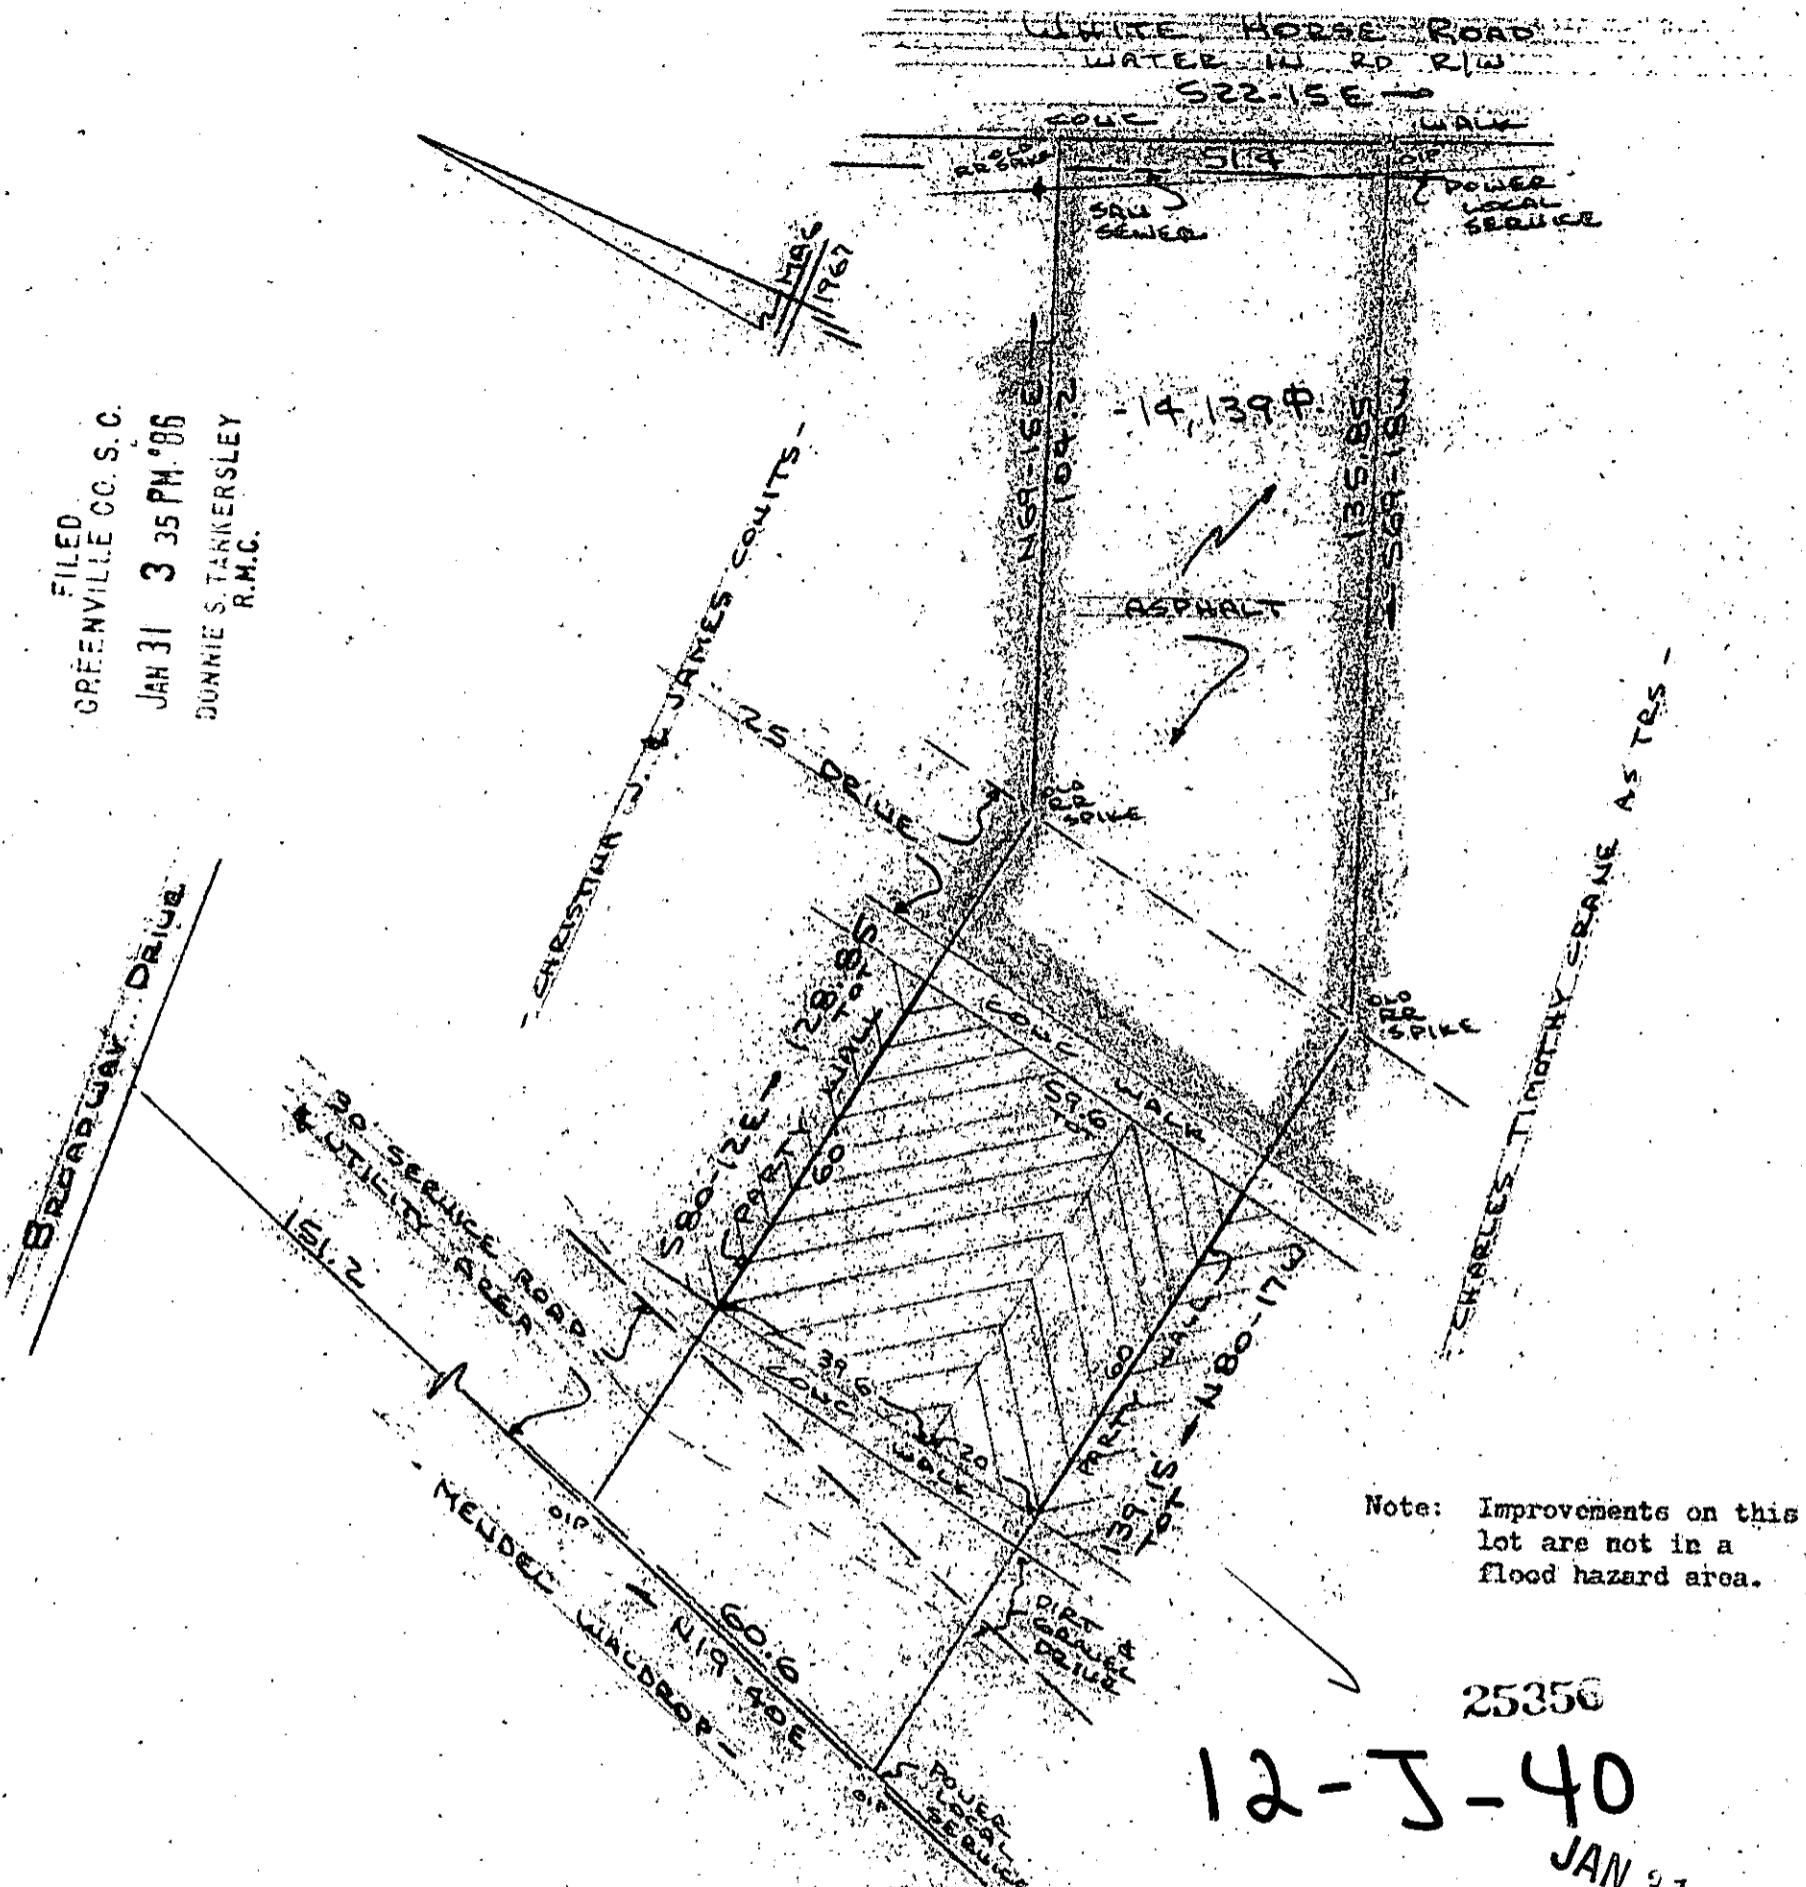

Note: Improvements on this lot are not in a flood hazard area.

25356

12-J-40

JAN 31 1986

PROPERTY OF
LARRY S. RUMFELT & FORREST H. RUMFELT
NEAR GREENVILLE GREENVILLE CO. S.C.
SCALE 1"=30' 30 JAN 1986

This is to certify that on the 30th day of January, 1986, I surveyed the property shown on this plat, being known as WESTWOOD PLAZA and recorded in the RMC Office Greenville County, S. C., in Plat Book "VVV" at Page 111 and also known as PROPERTY OF LARRY S. RUMFELT & FORREST H. RUMFELT and recorded in Plat Book at Page ; and that the property lines, walls and buildings are as shown hereon, and that the walls and buildings located on said lot do not encroach or project on adjacent street or property, and that no adjacent walls or buildings encroach or project on said premises, and no power lines cross this property except as shown hereon.

R. B. Bruce
R. B. Bruce, RLS # 1952

CAROLINA SURVEYING CO.
Greenville, S. C.

Recordable Plat