

MICROFILMED


(151) S 12-50W 750' EIP (149)

(243)

(244)

(245)

FILED
GREENVILLE CO., S.C.
FEB 14 12 49 PM '86
DONNIE S. TANKERSLEY
R.M.C.

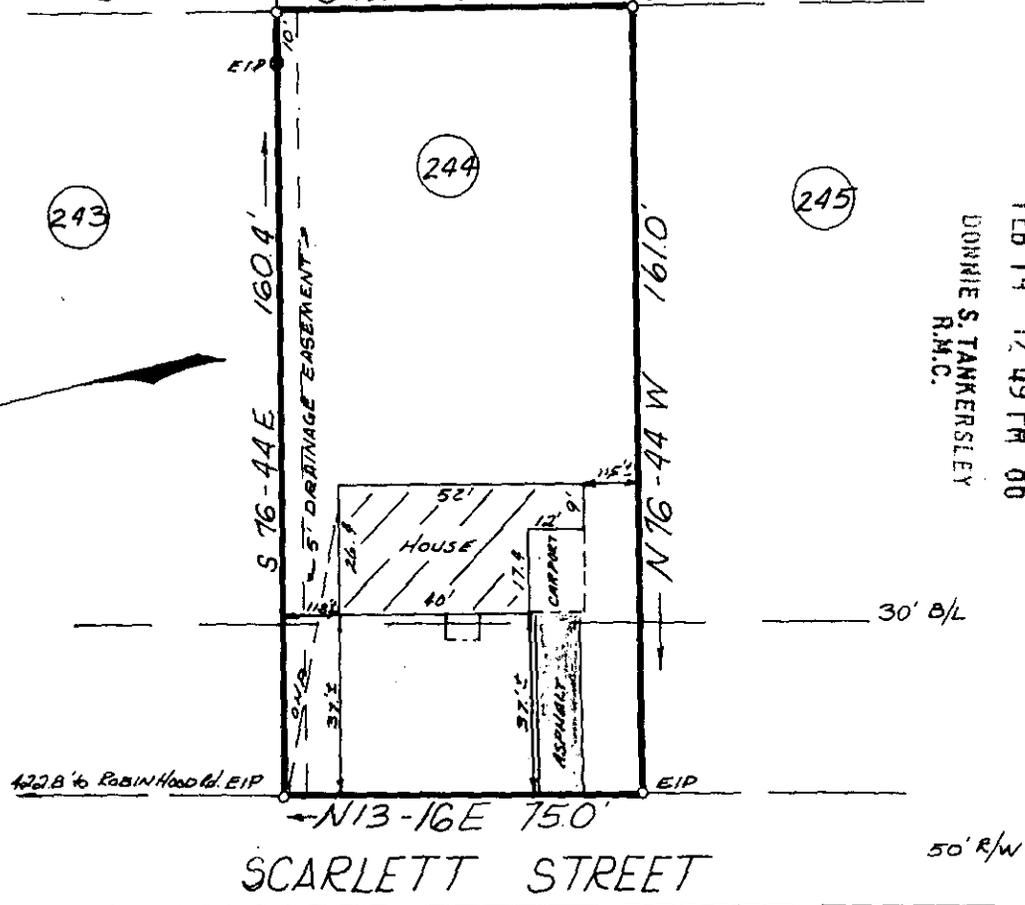

PROPERTY OF

ROY L. HOOPER

GREENVILLE, G'VILLE COUNTY, SOUTH CAR.
FEBRUARY 12, 1986 SCALE 1"=40'

This is to certify that on February 12, 1986, I surveyed the property shown on this plat, known as Lot No. 244 of Sherwood Forest, as recorded in the RMC Office for Greenville County, in Plat Book GG, page 23, and that the property lines, walls and buildings are as shown hereon, and that the building located on said lot does not project nor encroach on adjacent streets or property, and that no adjacent walls or buildings project nor encroach on said lot, and that no utility lines cross this lot except as may be shown hereon. The degree of accuracy is 1/10,000.

NOTE: This property is not located within a flood hazard area.

Survey by; Richard D. Wooten, Jr.
Greenville, South Carolina

300 3
11A01

12-K-33

26333 ✓

Richard D. Wooten, Jr.
S. C. R. L. S. No. 4578



FEB 14 1986

RECORDABLE PLAT

DWG 4632