

FILED
 GREENVILLE CO., S.C.
 FEB 14 3 29 PM '86
 DONNIE S. TANKERSLEY
 R.M.C.

PROPERTY OF
W. RAY WYATT
 &
SHERRY M. WYATT

NEAR GREENVILLE, GREENVILLE COUNTY, SOUTH CAR.
 FEBRUARY 7, 1986 SCALE 1"=40'

This is to certify that on February 7, 1986, I surveyed the property shown on this plat known as Lot No. 6-B of "Addition to Cherokee Forest" as recorded in the RMC Office for Greenville County in Plat Book RR at Page 141, and that the property lines, walls and buildings are as shown hereon, and that the building located on said lot does not project nor encroach on adjacent streets or property, and that no adjacent walls or buildings project nor encroach on said lot, and that no utility lines cross this lot except as may be shown hereon.

NOTE: This property is not located within a flood hazard area.


5' drainage and utility easement along all side and rear lot lines.

Surveyed by: Richard D. Wooten, Jr.
 Greenville, South Carolina

Richard D. Wooten, Jr.
 S. C. R. L. S. No. 4698

26937

12-K-36

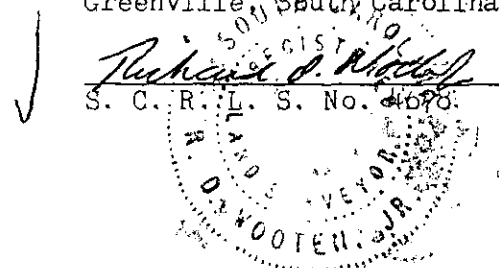

RECORDABLE PLAT