


FILED
NO. 9 GREENVILLE CO., S.C.
FEB 27 2 13 PM '86
DONNIE S. TANKERSLEY
R.M.C.

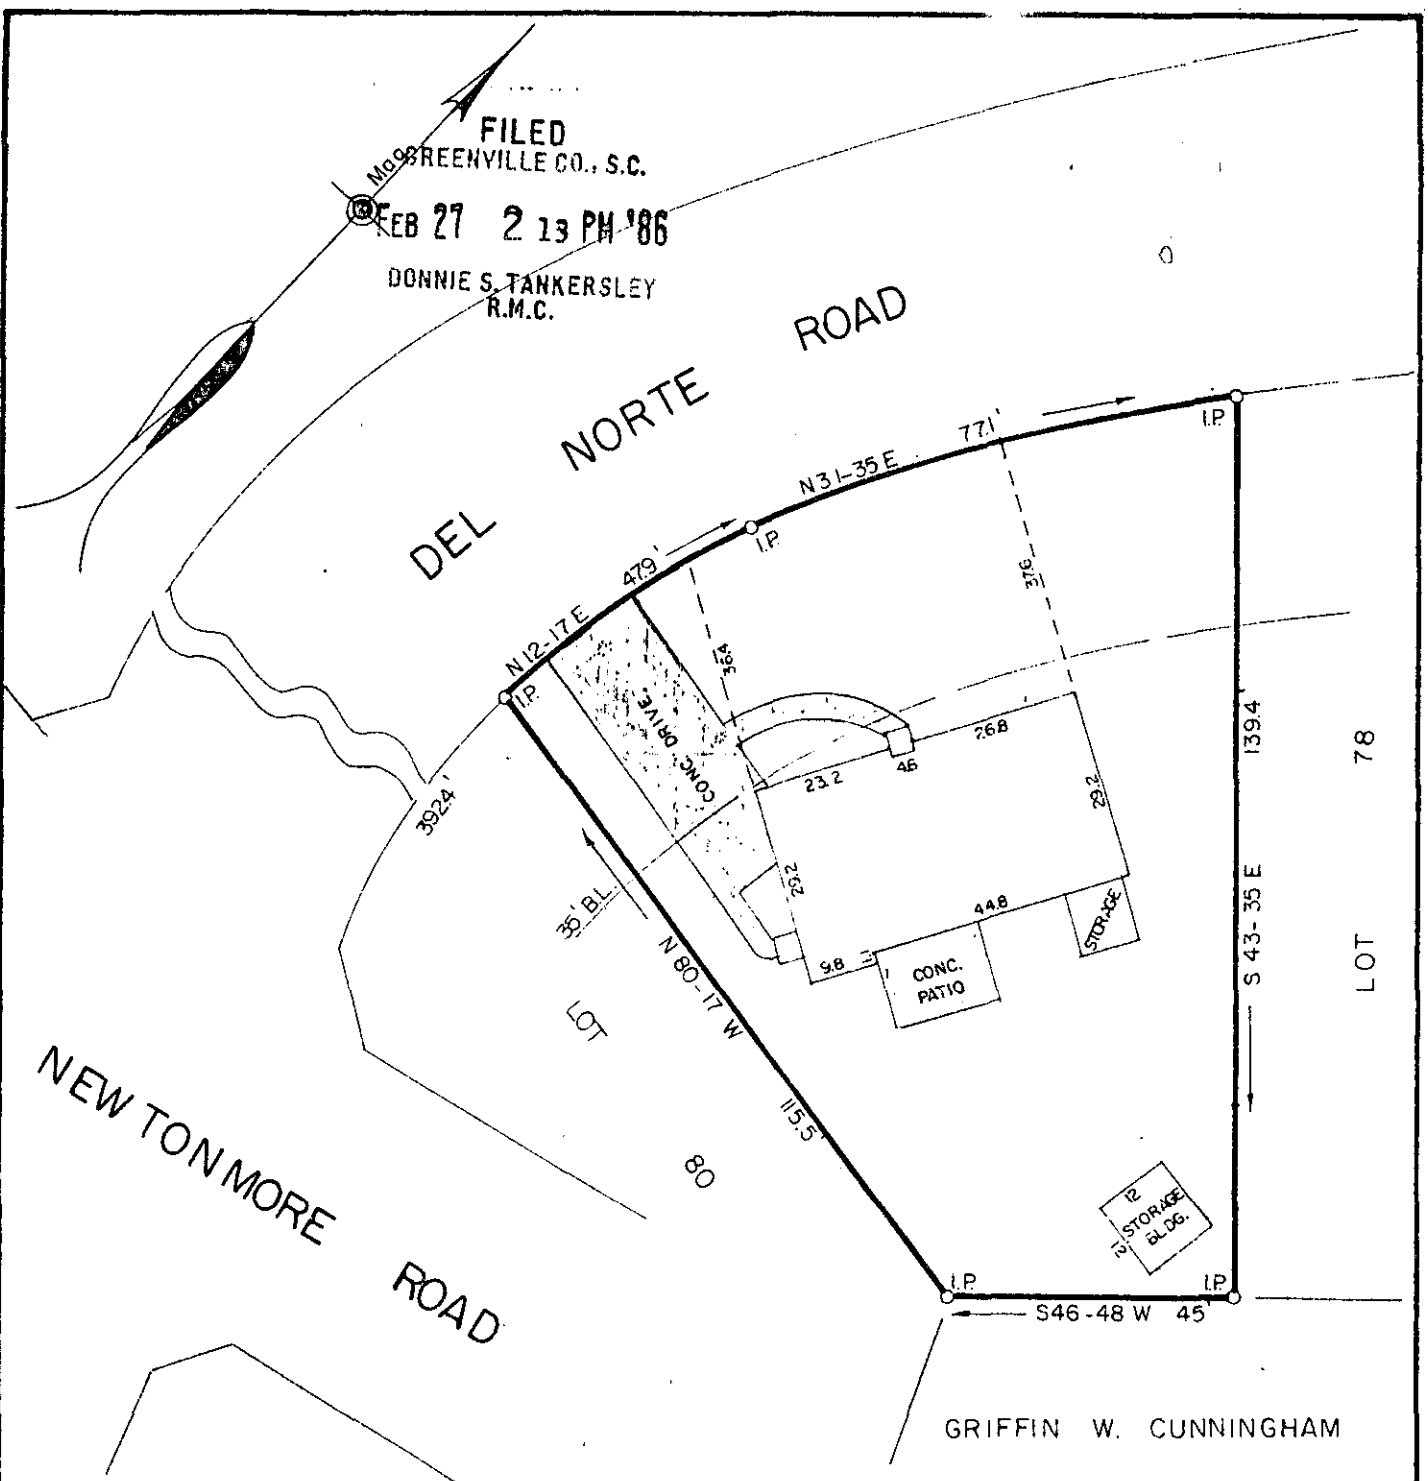

PROPERTY OF
DAVID H. HAMES
JUDY C. HAMES
GREENVILLE COUNTY, S.C.

FEB 27 1986

✓ 28144

12-K-79

Scale 1" = 30' February, 1986

This is to certify that on the 17th day of February, 1986, we surveyed the property shown on this plat being known as Lot 79 on plat of Del Norte Estates, Sheet Two, recorded in plat book WWW, page 33, Office of R.M.C., Greenville County, S.C.; and that the property lines, walls and buildings are as shown hereon; that the buildings located on said lot do not encroach or project on adjacent streets, or property; and that no adjacent buildings or walls encroach or project on said premises; and from information from Greenville County, this structure is not located in a designated flood area.

[Handwritten Signature]
DALTON & NEVES CO., INC. ENGINEERS

DALTON & NEVES CO., INC. ENGINEERS

FILED FEB 27 1986 1:30 P.M.