MICROFILMED

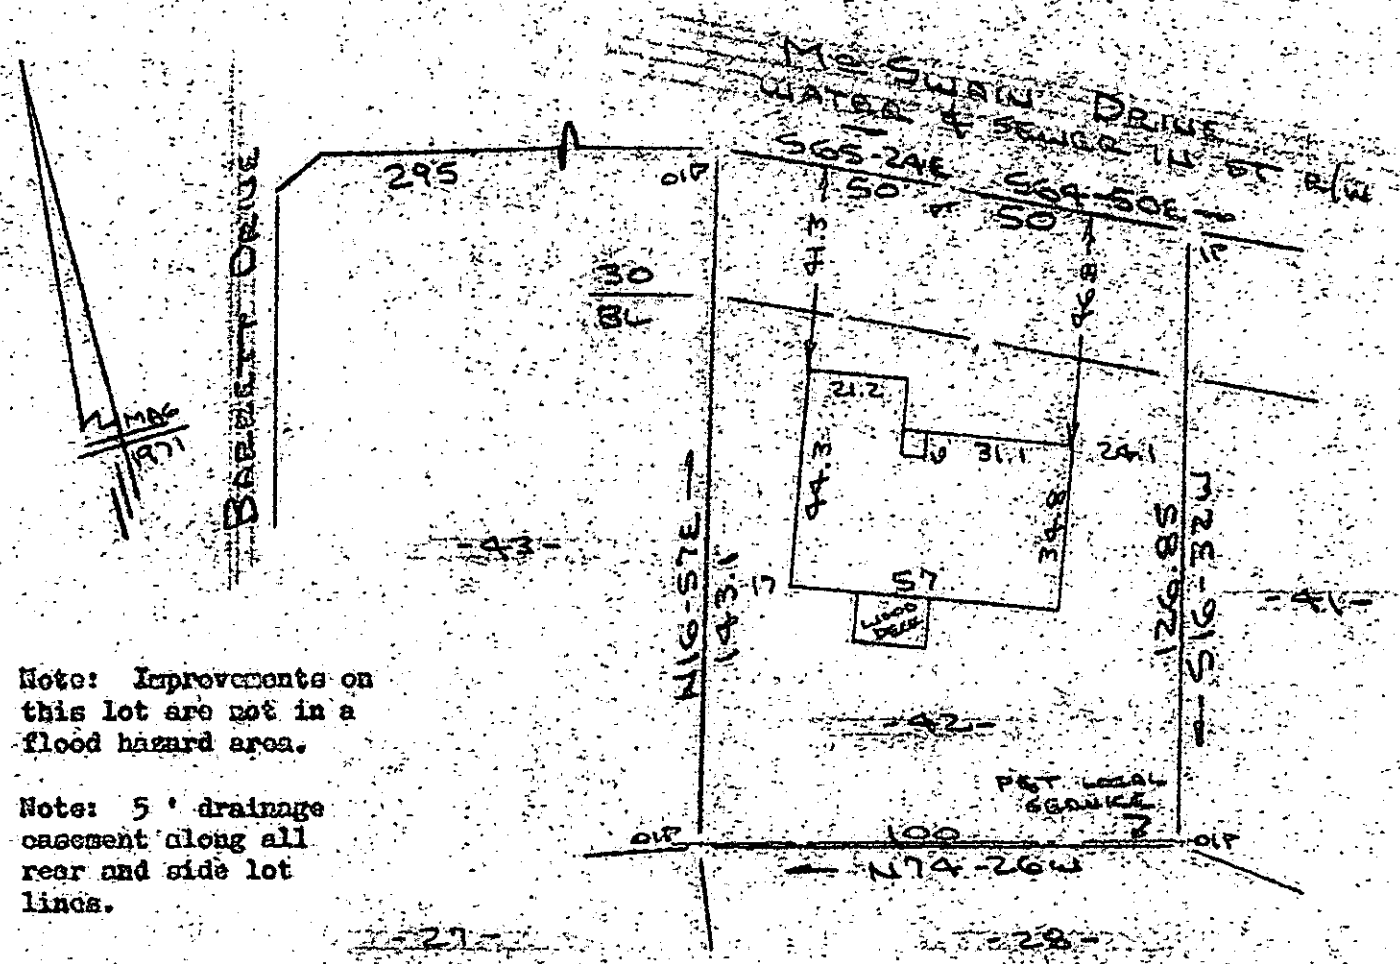

Note: Improvements on this lot are not in a flood hazard area.

Note: 5 ' drainage easement along all rear and side lot lines.

PROPERTY OF
ROBERT A. WITHEY & ALLENE Y. WITHEY
MAULDIN, S.C.
SCALE 1"=40' 26 FEB 1986

40 20 0 40

This is to certify that on the 26th day of February, 1986, I surveyed the property shown on this plat, being known as lot 42 on plat of BURDETT ESTATES and recorded in the RMC Office Greenville County, S. C., in Plat Book " 4 - X " at Page 60; and that the property lines, walls and buildings are as shown hereon, and that the walls and buildings located on said lot do not encroach or project on adjacent street or property, and that no adjacent walls or buildings encroach or project on said premises, no power lines cross this property and no visible encroachments except as shown hereon.

12-K-93 R. B. Bruce

28381 R. B. Bruce, RLS # 1952

CAROLINA SURVEYING CO.
112 Manly St.
Greenville, S. C.

Recordable Plat

FILED
GREENVILLE CO., S.C.
FEB 28 4 16 PM '86
DONNIE S. TANKERSLEY
R.M.C.

FE28 86 124

3.00

257/74 M42-1-205