MICROFILMED

FILED
GREENVILLE CO., S.C.
MAR 3 10 03 AM '86
DONNIE S. TANKERSLEY
R.M.C.

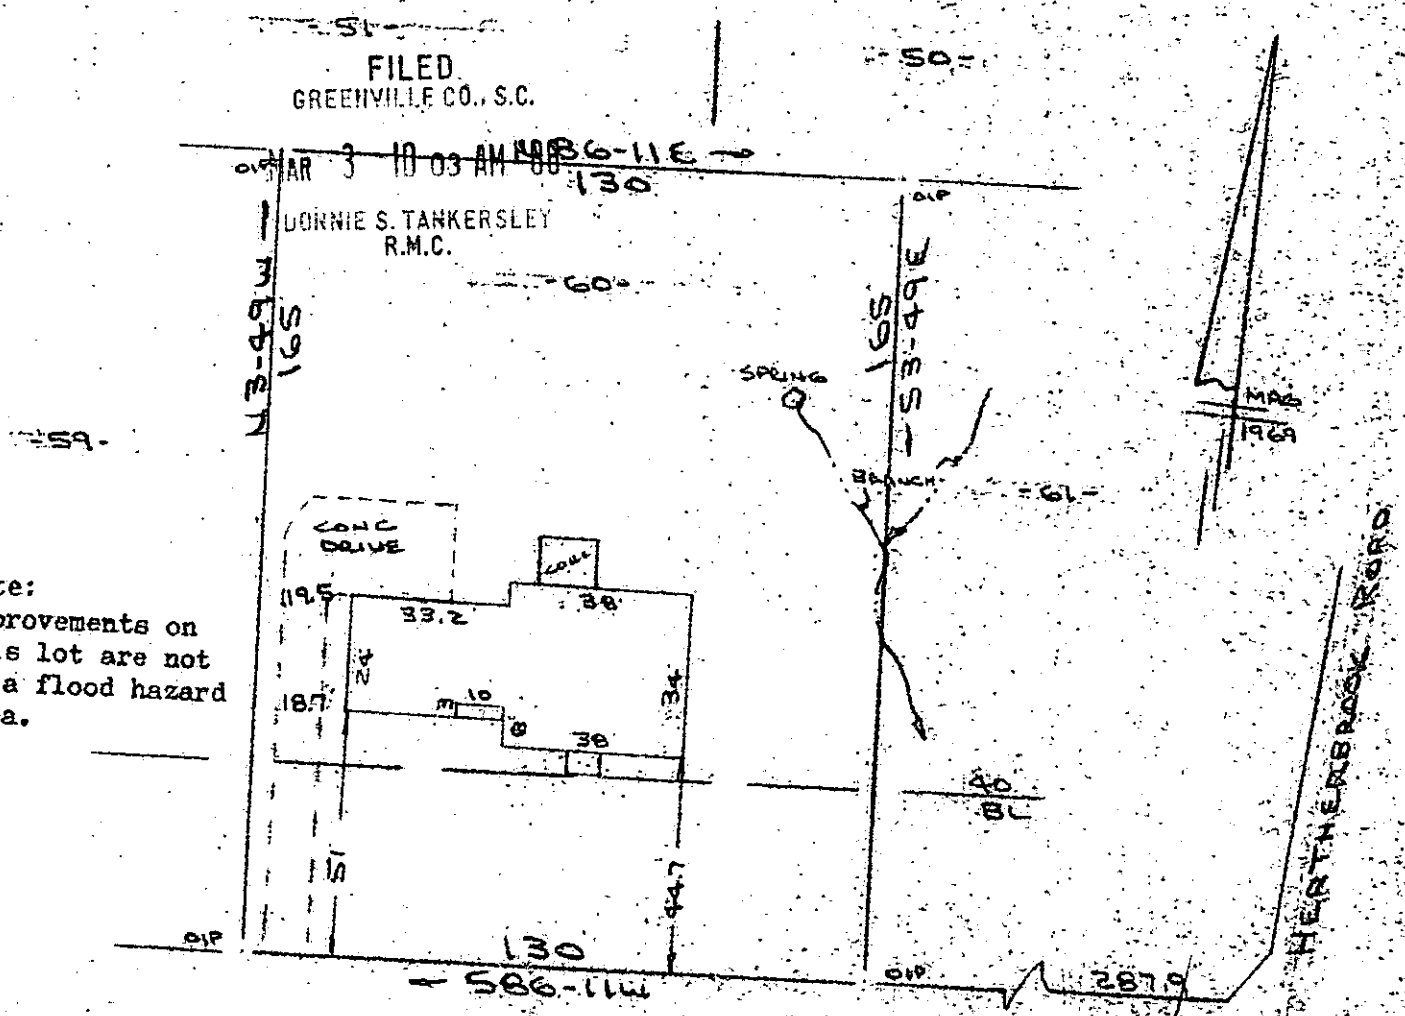


Note:
Improvements on this lot are not in a flood hazard area.

STONEHEDGE DRIVE
WATER & SEWER IN ST R/W

MAR 3 1986

28517

12-K-97

PROPERTY OF
J. MARTIN STOREY & BARBARA C. STOREY
NEAR GREENVILLE, S.C.
SCALE: 1" = 40' 25 FEB 1986

40 20 0 40

This is to certify that on the 25th day of Feb. , 1986 , I surveyed the property shown on this plat, being known as lot 60 on plat of MAP NO. 1 FOXCROFT and recorded in the RMC Office Greenville County, S. C., in Plat Book " 4 - F " at Page 2; and that the property lines, walls and buildings are as shown hereon, and that the walls and buildings located on said lot do not encroach or project on adjacent street or property, and that no adjacent walls or buildings encroach or project on said premises, and no power lines cross this property except as shown hereon.

R. B. Bruce
R. B. Bruce, PLS #1952

CAROLINA SURVEYING CO.
112 Manly St.
Greenville, S. C.

R. B. Bruce

3.00-3 1-1-A.0.1

252/79

540.7-1-60