



FILED
GREENVILLE CO., S.C.
MAR 11 3 15 PM '86
DONNIE S. TANWERSLEY
R.M.C.

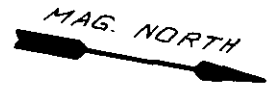

183

182

181

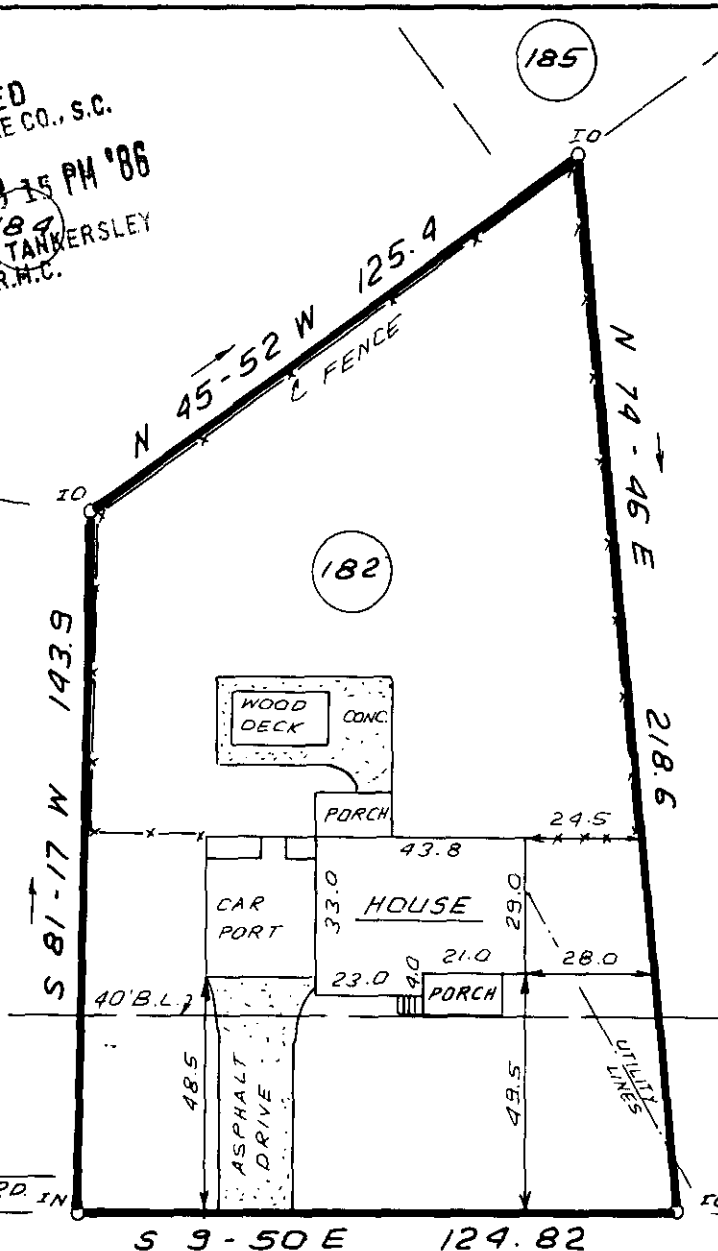

29631

121' ± TO
HERMITAGE RD. IN

ROCKMONT ROAD

MAR 11 1986
12-2-96



This is to certify that the property shown on this plat was surveyed under my direct supervision. Property lines and improvements shown are located correctly and that no visible encroachments exist unless otherwise shown. This property is not located in a designated flood hazard area.

RLS: JAMES R. FREELAND
NO. 4781

STATE OF SOUTH CAROLINA
GREENVILLE COUNTY

LAKE FOREST
SEC. 3, LOT 182
PROPERTY OF
MATTHEW S. GRAHAM
CAROL C. GRAHAM

FREELAND & ASSOCIATES
Engineers • Land Surveyors
318 WEST STONE AVENUE.
GREENVILLE, S.C.
(803) 271-4924

PLAT BOOK	66-76877
DEED BOOK	758-209
TAX MAP	277-2-192
PARTY CHIEF	J.R.F.
DRAWN	I.R.
DATE	MARCH-3-86
DWG NO	14712