
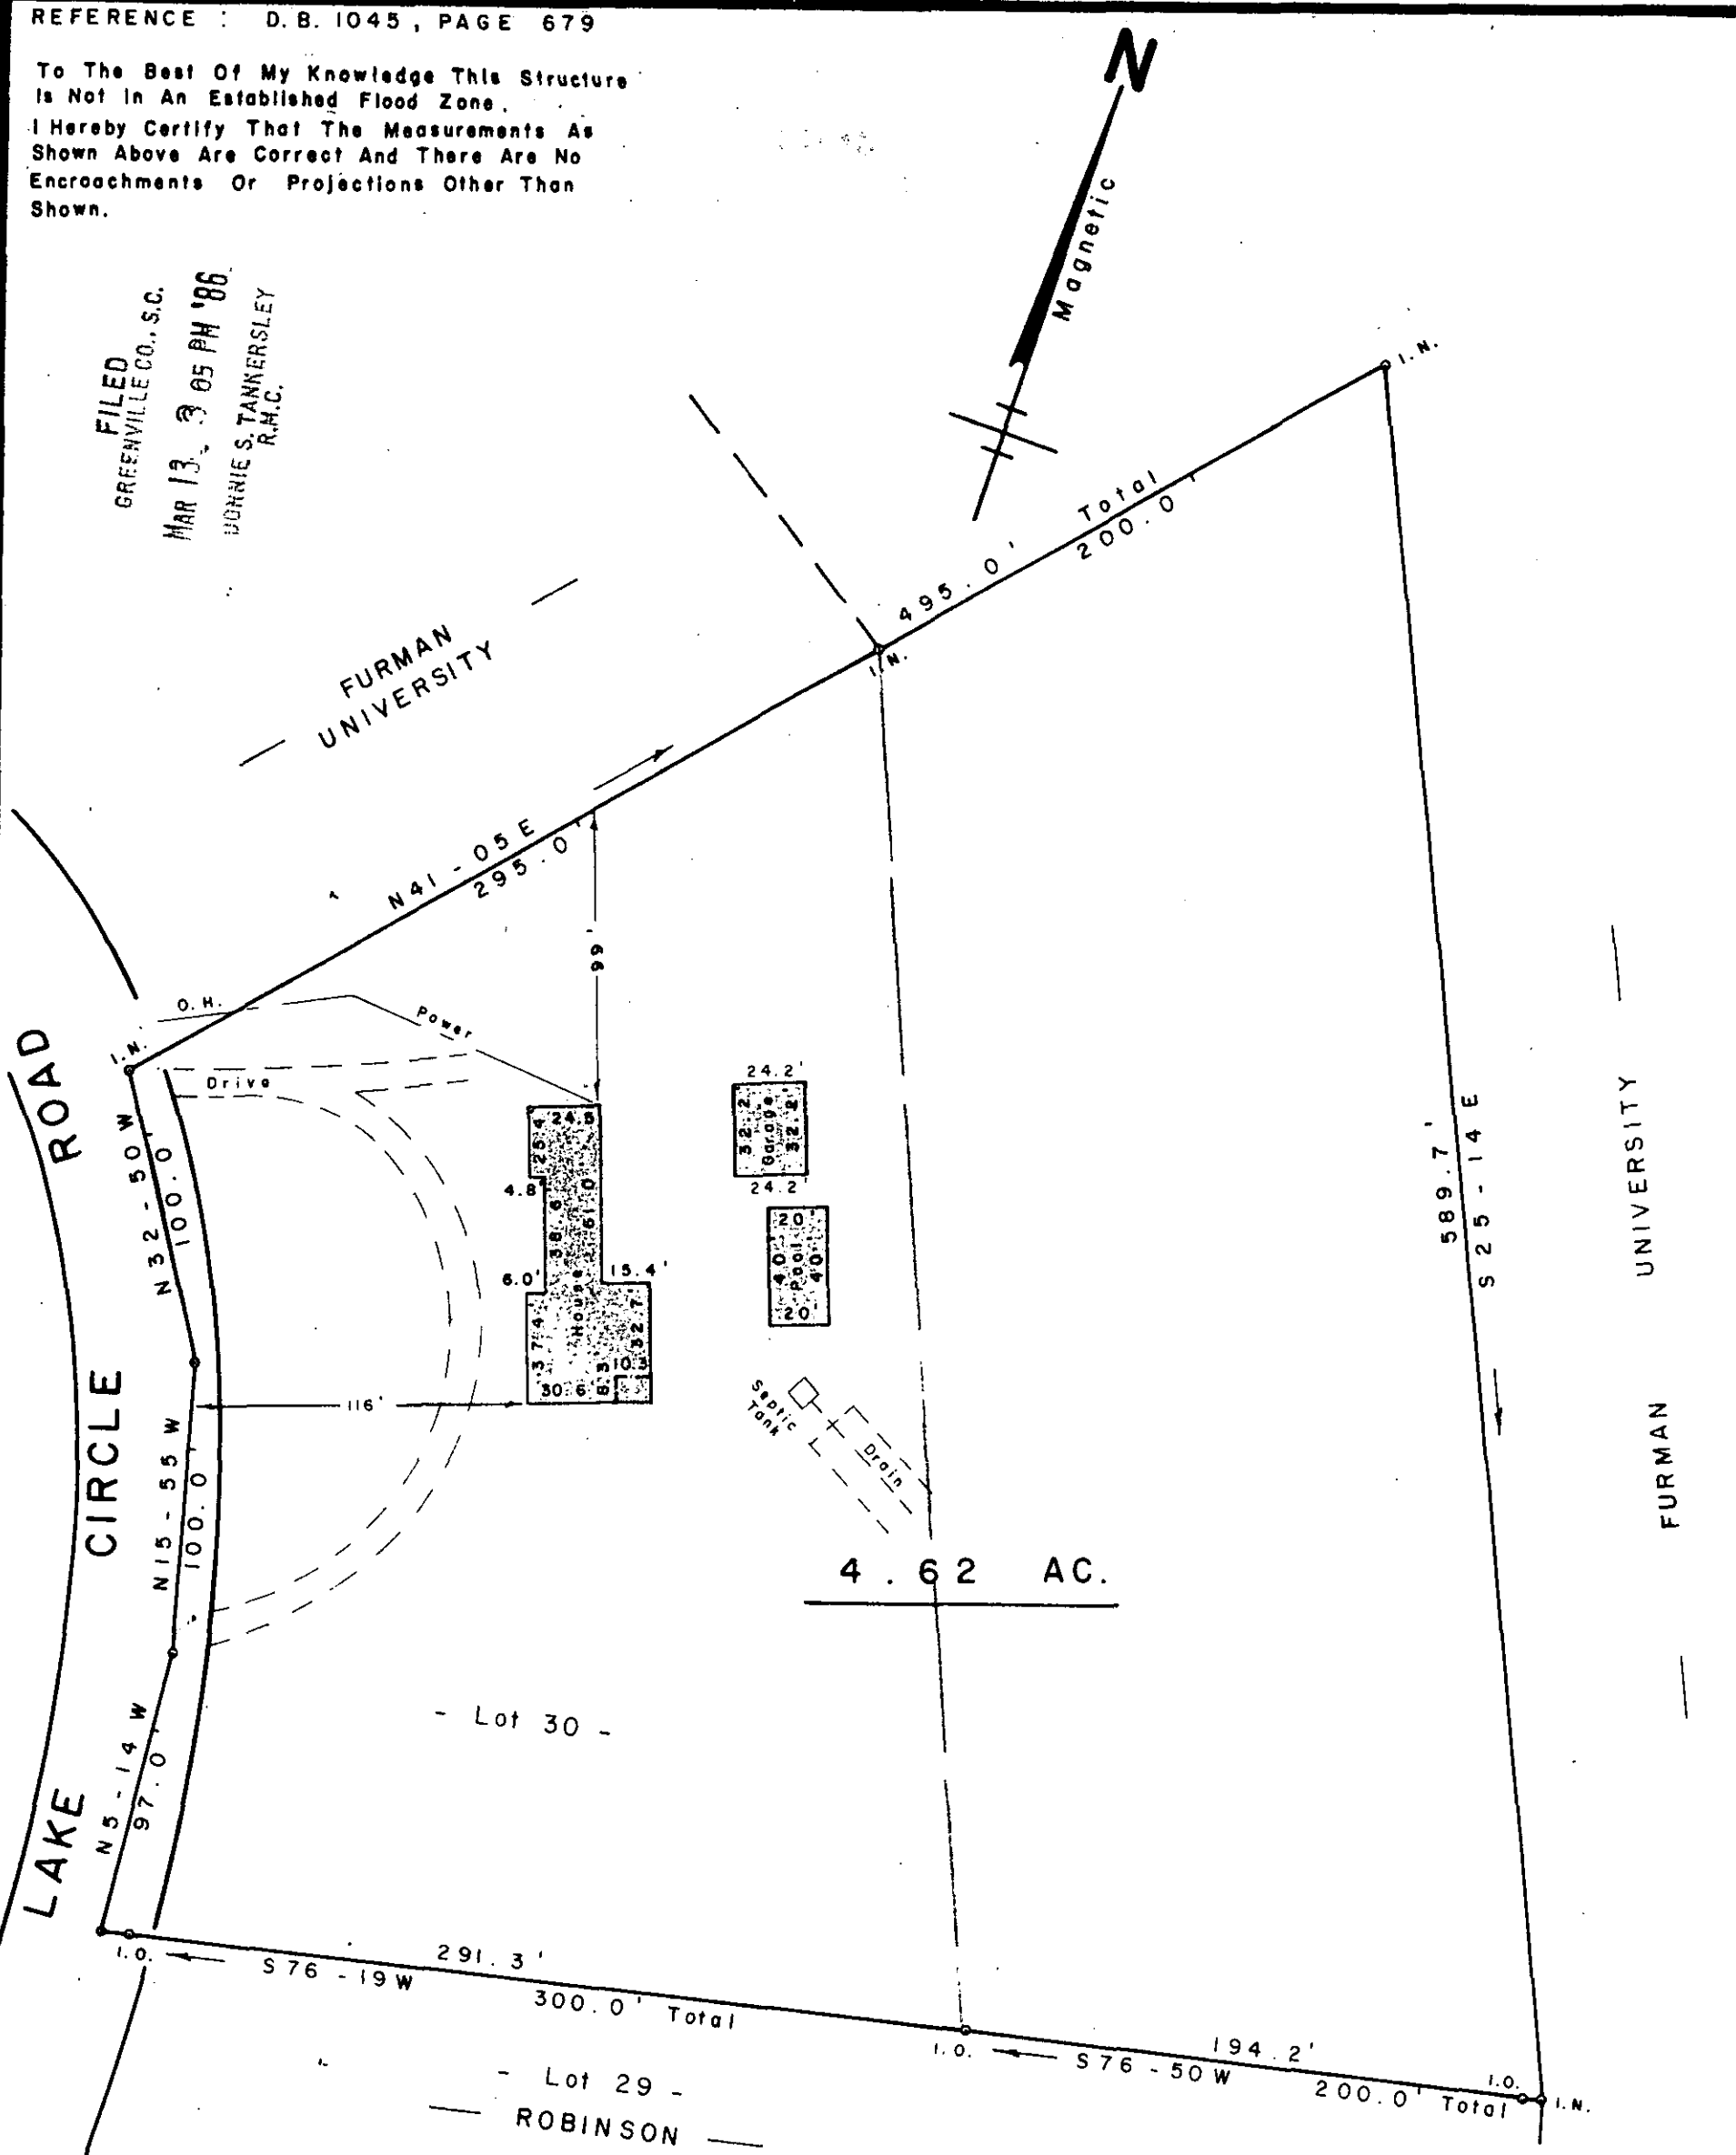


REFERENCE : D. B. 1045 , PAGE 679

To The Best Of My Knowledge This Structure Is Not In An Established Flood Zone. I Hereby Certify That The Measurements As Shown Above Are Correct And There Are No Encroachments Or Projections Other Than Shown.


FILED  
GREENVILLE CO., S.C.  
MAR 13 3 05 PM '86  
WONNIE S. TANKERSLEY  
R.M.C.

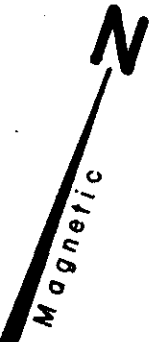

SURVEY FOR  
**O'NEIL P. BOUDREAUX, JR.**  
**GAIL ANN BOUDREAUX**  
PARIS MTN. GREENVILLE CO.

SOUTH CAROLINA  
JANUARY 28, 1983

SCALE: 1" = 60'

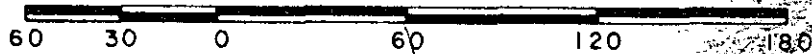

29992



W. R. WILLIAMS, JR.  
ENGR. / SURVEYOR, Inc.  
P. E. & L. S. No. 3979  
15 S. MAIN STREET  
TRAVELERS REST, S. C.  
29690

I hereby certify that the total precision of the field survey is 1/40000 as shown hereon and the area was determined by the method of area calculation

W. R. Williams, Jr. P. E. & L. S. No. 3979