
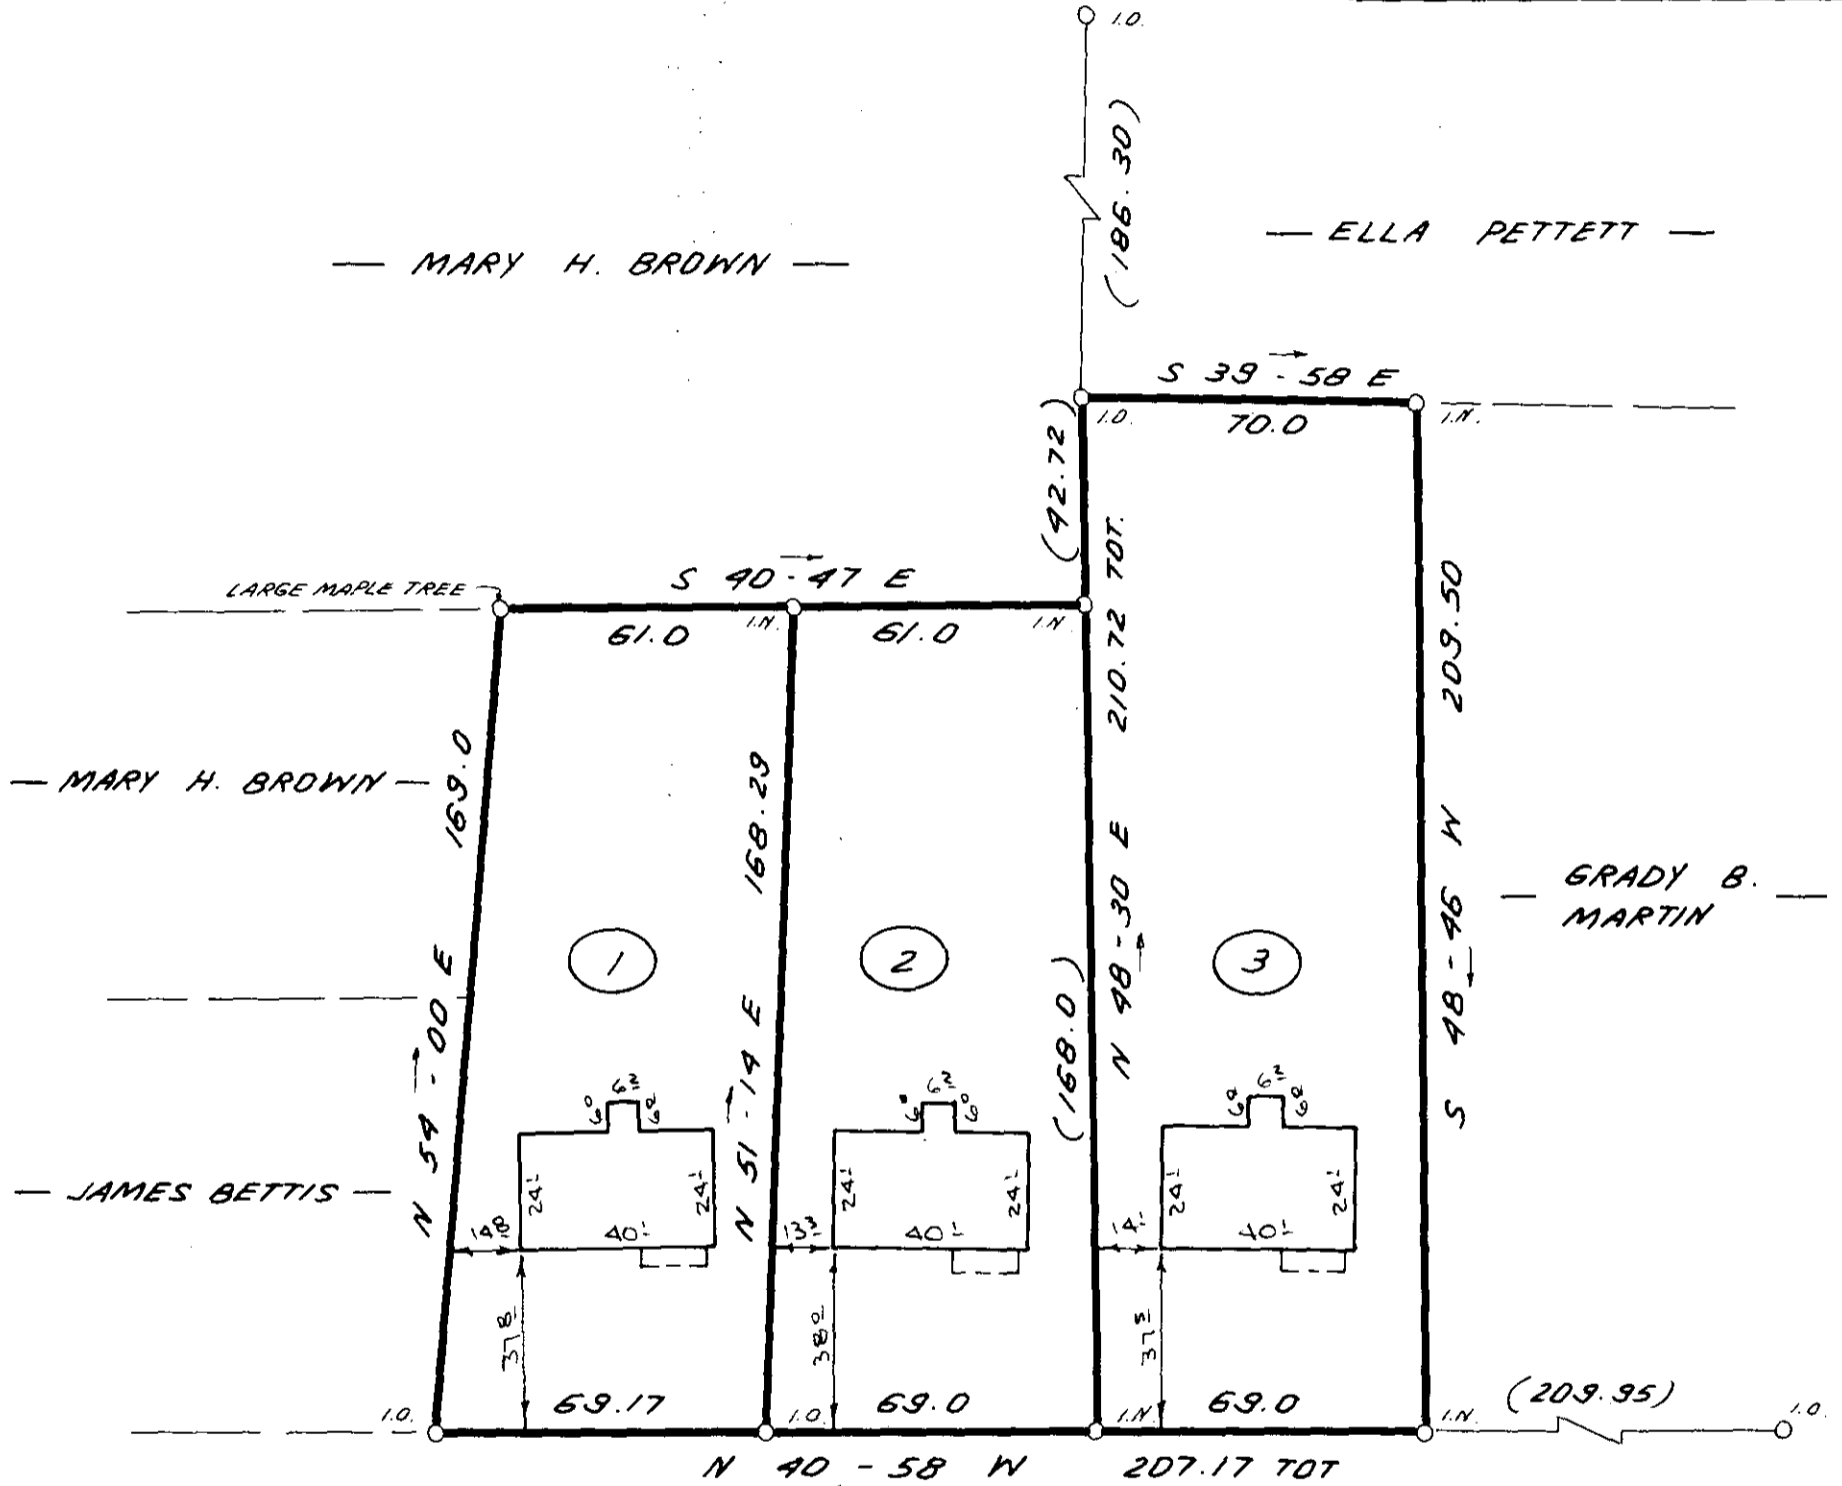
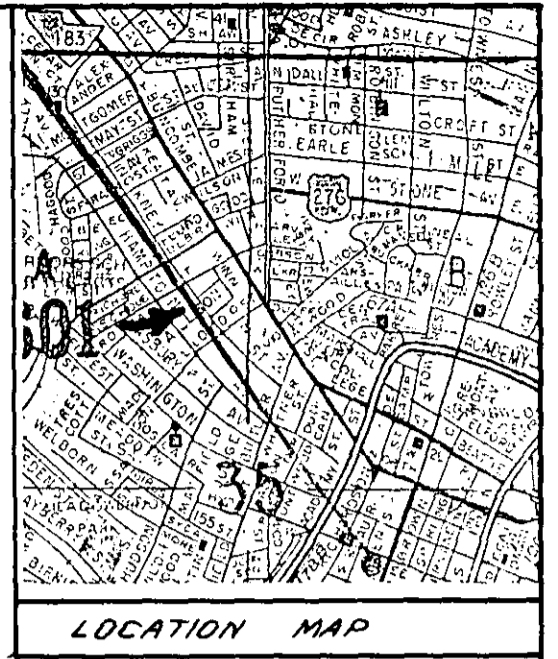


REFERENCE :

DEED BOOK 1080-670
1093-160
BLOCK BOOK 22-1-13,14,15

GREENVILLE CO. S. C.
APR 11 11 59 AM '86
DONNIE S. TANKERSLEY
R.M.C.

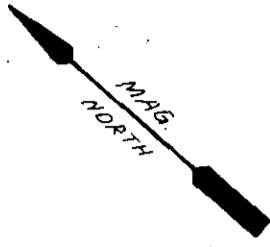

HAMPTON AVENUE

33432

12-M-18

SURVEY FOR

CITY OF GREENVILLE

GREENVILLE SOUTH CAROLINA

NOV. 18, 1985

SCALE: 1" = 40'



REFERENCE PLAT.

This is not a subdivision. This plat is for reference purposes only and is not to be used to create new lots or roads.

APR 11 1986



W. R. WILLIAMS, JR.
ENGR. / SURVEYOR, Inc.
P. E. & L. S. No. 3979
15 S. MAIN STREET
TRAVELERS REST, S. C.
29690

F.B. # 83

REVISED 2-26-86
HOUSE LOCATION

hereby certify that the ratio of precision of the field survey is 1/10000 as shown hereon and the area was determined by DMD method of area calculation.