


PROPERTY OF
DONALD J. REED & SHARON M. REED
NEAR GREENVILLE, S.C.
SCALE 1"=40' 6 MAR 1986

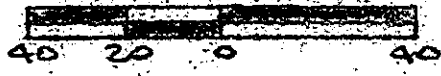

This is to certify that on the 6th day of March, 1986, I surveyed the property shown on this plat, being known as lot 85 on plat of HOLLY TREE PLANTATION PHASE III SECTION NO. 1 SHEET NO. 1 and recorded in the REC Office Greenville County, S. C., in Plat Book " 6 - H " at Page 74; and that the property lines, walls and buildings are as shown hereon, and that the walls and buildings located on said lot do not encroach or project on adjacent street or property, and that no adjacent walls or buildings encroach or project on said premises, no power lines cross this property and no visible encroachments except as shown hereon.

MAR 14 1986
12-N-18 R. B. Bruce

R. E. Bruce, RLS # 1952

CAROLINA SURVEYING CO. Greenville, S. C. Recordable Plat

300 3 21A01