


FILED  
GREENVILLE CO. S.C.

MAR 31 2 25 PM '86

EASEMENT  
DUNNIE S. PAKERSLEY  
R.M.C.

464

463

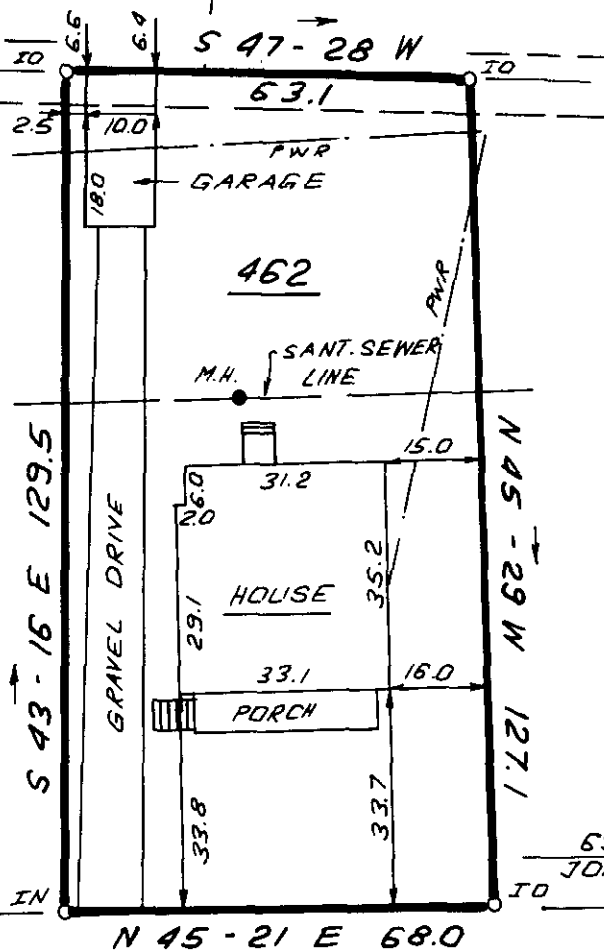

465

460

DORSEY BOULEVARD

MAR 31 1986

31913

12-N-91




THIS IS TO CERTIFY THAT THE PROPERTY SHOWN ON THIS PLAT WAS SURVEYED UNDER MY DIRECT SUPERVISION PROPERTY LINES AND IMPROVEMENTS SHOWN ARE LOCATED CORRECTLY AND THAT NO VISIBLE ENCROACHMENTS EXIST UNLESS OTHERWISE SHOWN. THIS PROPERTY IS NOT LOCATED IN A DESIGNATED FLOOD HAZARD AREA

**STATE OF SOUTH CAROLINA  
GREENVILLE COUNTY**

ABNEY MILLS  
SEC. 2, LOT 462  
PROPERTY OF  
BRIAN C. AND BARBARA A.  
TEMPELTON

**FREELAND-CLINKSCALES  
& ASSOCIATES, INC.**  
Engineers • Land Surveyors  
323 WEST STONE AVENUE  
GREENVILLE, S.C.  
(803) 271-4924

|             |                    |
|-------------|--------------------|
| PLAT BOOK   | 22 - 58 - 59       |
| DEED BOOK   |                    |
| TAX MAP     | 118.00 - 05.00 400 |
| PARTY CHIEF | R.J.               |
| DRAWN       | I.R.               |
| DATE        | MARCH - 28 - 86    |
| DWG. NO.    | 14861              |

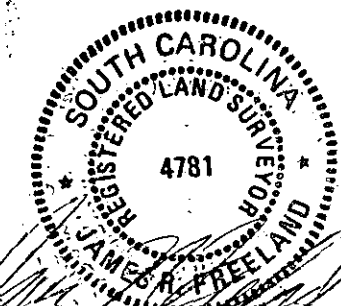

RLS JAMES R. FREELAND  
NO 4781