MICROFILMED

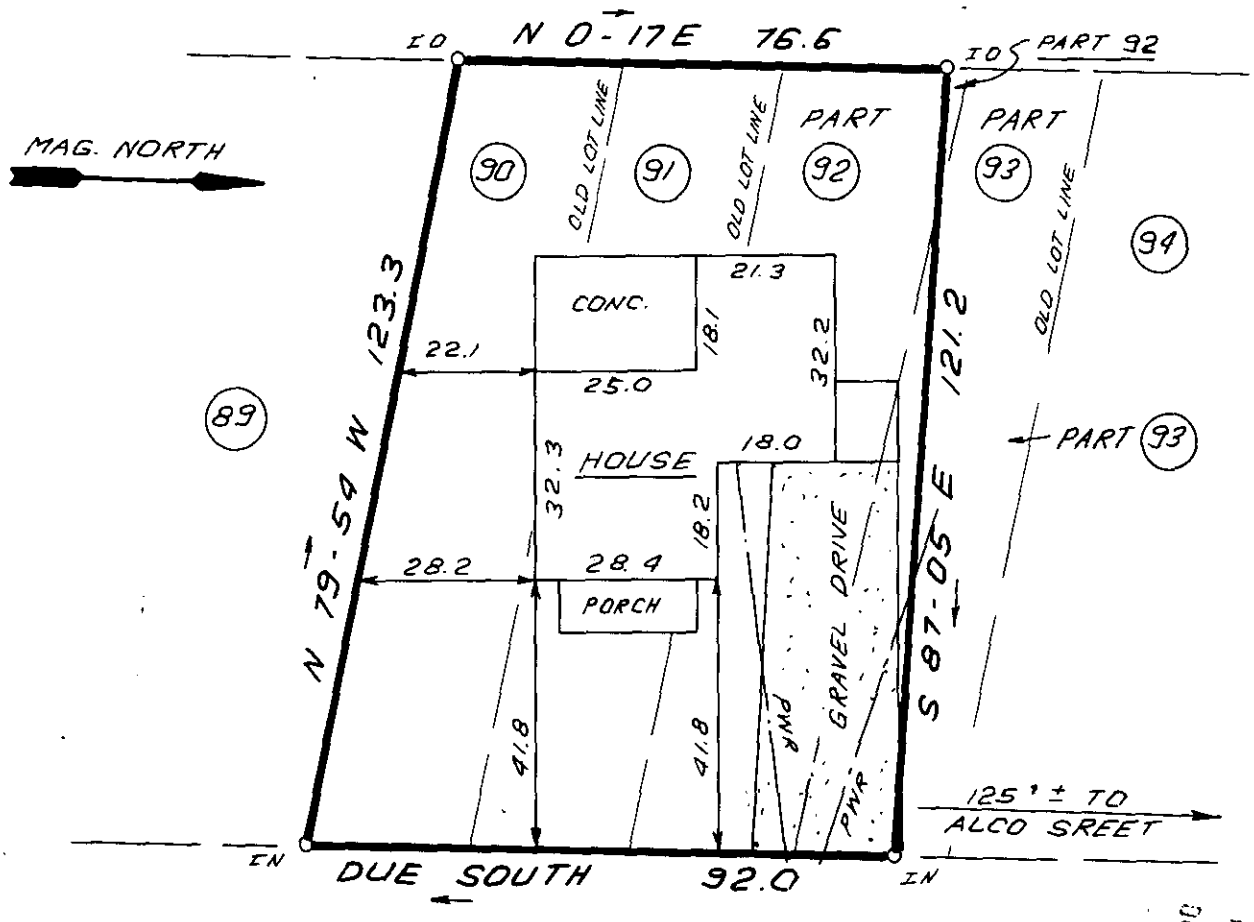


HALCOX STREET

FILED
GREENVILLE CO. S.C.
APR 1 2 35 PM '06
DONNIE S. TANKERSLEY
R.M.C.

32195

12-0-10

30 0 30 60

SCALE: 1" = 30' FEET

THIS IS TO CERTIFY THAT THE PROPERTY SHOWN ON THIS PLAT WAS SURVEYED UNDER MY DIRECT SUPERVISION. PROPERTY LINES AND IMPROVEMENTS SHOWN ARE LOCATED CORRECTLY AND THAT NO VISIBLE ENCROACHMENTS EXIST UNLESS OTHERWISE SHOWN. THIS *PROPERTY* IS *NOT* LOCATED IN A DESIGNATED FLOOD HAZARD AREA.

SOUTH CAROLINA REGISTERED LAND SURVEYOR
5-7-67

F.V. CLINKSCALES, RLS-PE
NO. 5767

**STATE OF SOUTH CAROLINA**
**GREENVILLE COUNTY**

CUTTINO HEIRS PROP.
SEC. H ; LOTS 90, 91 & PT. LOTS 92, 93
PROPERTY OF
DONALD J. STOTTMEISTER
JUDITH L. STOTTMEISTER


**FREELAND-CLINKSCALES & ASSOCIATES, INC.**
*Engineers • Land Surveyors*
323 WEST STONE AVENUE
GREENVILLE, S.C.
(803) 271-4924


| | |
|---|---|
| PLAT BOOK | J - 121 |
| DEED BOOK | 1035 - 920 |
| TAX MAP | P 12 - 4 - 1 |
| PARTY CHIEF | J. C. |
| DRAWN | I. R. |
| DATE | MARCH - 31 - 86 |
| DWG. NO. | 14868 |


THE PRINT MACHINE, INC. N74712


300 8 11801