


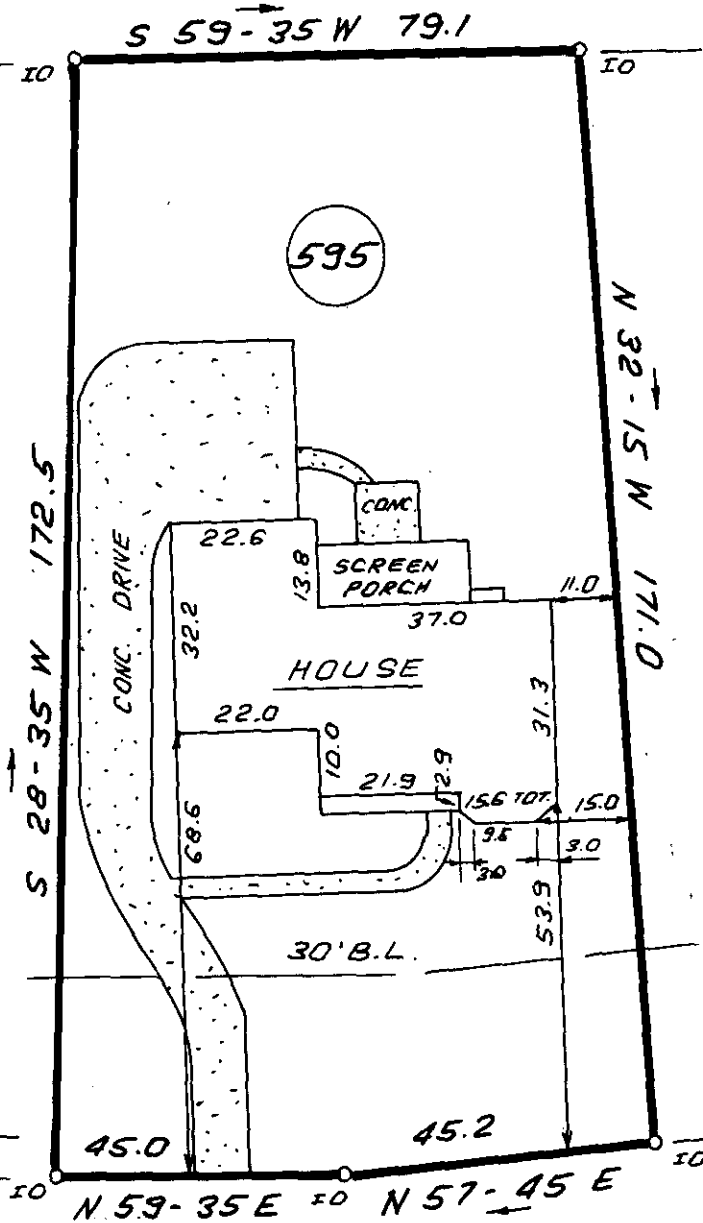

596

FILED
GREENVILLE CO. S.C.
APR 4 9 28 AM '86
JONNIE S. TANKERSBET
R.M.C.
595



APR 4 1986

32669


12-0-25

STONE CREEK ROAD



NOTE: 5' DRAINAGE & UTILITY EASEMENT
ALONG EACH SIDE OF ALL SIDE & REAR
LOT LINES.

THIS IS TO CERTIFY THAT THE PROPERTY SHOWN ON THIS PLAT WAS SURVEYED UNDER MY DIRECT SUPERVISION. PROPERTY LINES AND IMPROVEMENTS SHOWN ARE LOCATED CORRECTLY AND THAT NO VISIBLE ENCROACHMENTS EXIST UNLESS OTHERWISE SHOWN. THIS PROPERTY IS NOT LOCATED IN A DESIGNATED FLOOD HAZARD AREA.

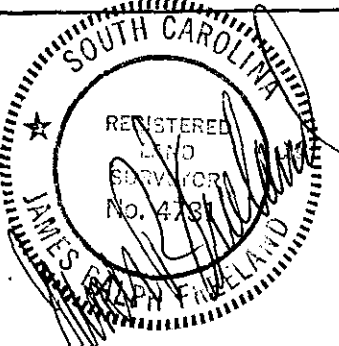

STATE OF SOUTH CAROLINA
GREENVILLE COUNTY

SUGAR CREEK
SEC. 3, LOT 595
PROPERTY OF
RONALD AND SHARON JEAN
PFENNIG

FREELAND-CLINKSCALES & ASSOCIATES, INC. Engineers • Land Surveyors 323 WEST STONE AVENUE GREENVILLE, S.C. (803) 271-4924	
PLAT BOOK	9F-35
DEED BOOK	
TAX MAP	
PARTY CHIEF	J.C.
DRAWN	I.R.
DATE	APRIL-3-86
DWG. NO.	14904

RLS: JAMES R. FREELAND
NO: 4781

5010 -----2 AP 4 86 001 3.0001