

FILED
 GREENVILLE CO. S.C.
 APR 8 12 10 PM '86
 DONNIE S. TANKERSLEY
 R.M.C.

FOUNDATION SURVEY
 PROPERTY OF

MARTIN & PITTMAN BUILDERS INC.

MAULDIN, GREENVILLE CO., S.C.
 APRIL 5, 1986 SCALE 1" = 40'

APR 8 1986


12-0-36 33021

This is to certify that on April 5, 1986, I located the foundation on the property known as Lot No. 14 of Wood Creek, as recorded in the RMC Office for Greenville county, in Plat Book 11-I, Page 27, and that the property lines, walls and foundation are as shown hereon, and that the foundation located on said lot does not project nor encroach on adjacent streets or property, and that no adjacent walls or buildings project nor encroach on said lot.

NOTE: This property is not located within a flood hazard area.

Survey by: Richard D. Wooten, Jr.
 Greenville, South Carolina

There is a 5' utility and drainage easement along each side all side and rear lot lines.

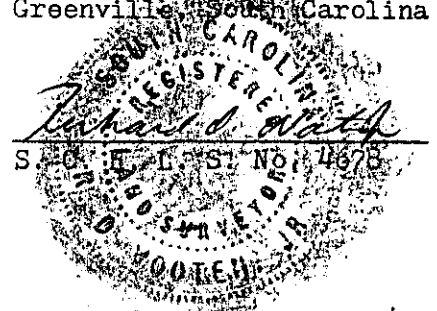

RECORDABLE PLAT

3019 -----2 AP 8 86 219
 3.00CI