

FILED
 GREENVILLE CO. S.C.
 APR 10 9 11 AM '86
 BONNIE S. TANKERSLEY
 R.M.C.

12

11


10

14

13

83' ± TO
LAUREL DRIVE

SKYLINE DRIVE

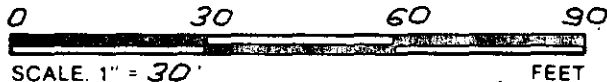

12-0-44

33237 ✓

THIS IS TO CERTIFY THAT THE PROPERTY SHOWN ON THIS PLAT WAS SURVEYED UNDER MY DIRECT SUPERVISION
 PROPERTY LINES AND IMPROVEMENTS SHOWN ARE LOCATED CORRECTLY AND THAT NO VISIBLE ENCROACHMENTS
 EXIST UNLESS OTHERWISE SHOWN THIS PROPERTY IS NOT LOCATED IN A DESIGNATED FLOOD HAZARD AREA



**STATE OF SOUTH CAROLINA
 GREENVILLE COUNTY**

**FREELAND-CLINKSCALES
 & ASSOCIATES, INC.**
 Engineers • Land Surveyors
 323 WEST STONE AVENUE
 GREENVILLE, S.C.
 (803) 271-4924

LAUREL HILLS
LOT II
 PROPERTY OF
WALLACE A. RIDDLE
HOMER E. DAVIS ✓

PLAT BOOK	2 R - 33
DEED BOOK	1259 - 403
TAX MAP	T 9.5-1-108
PARTY CHIEF	L.T.
DRAWN	I.R.
DATE	APRIL - 8 - 86
DWG NO.	14945

PLS JAMES R. FREELAND
 NO 4781