MICROFILMED

Note:
Improvements on this lot are not in a flood hazard area.

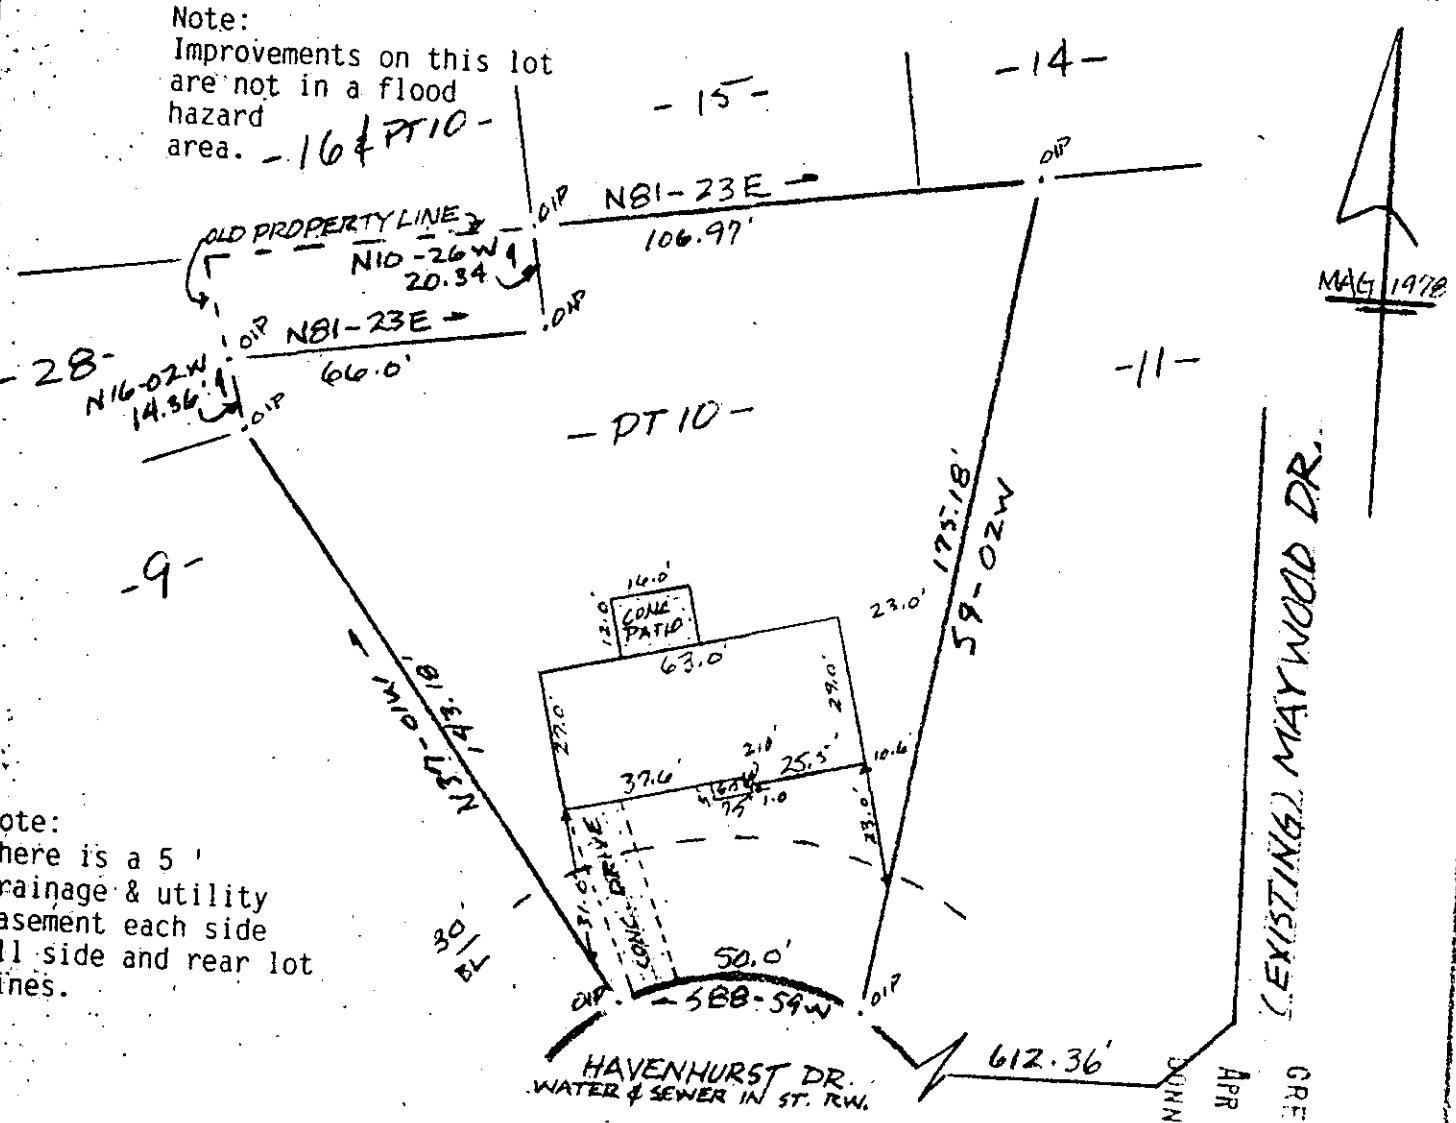

Note:
There is a 5 ' drainage & utility easement each side all side and rear lot lines.

PROPERTY OF
NORMAN H. KEESEE & TINA J. KEESEE
NEAR GREENVILLE, S.C.
SCALE 1" = 40'
7 APRIL, 1986

40 20 0 40

FILED
GREENVILLE CO. S.C.
APR 10 11 39 AM '86
DONNIE S. TANKERSLEY
R.M.C.

This is to certify that on the 7th day of April, 1986, I surveyed the property shown on this plat, being known as part of lot 10 on plat of HOMESTEAD ACRES II and recorded in the RMC Office Greenville County, S. C., in Plat Book " 6 - H " at Page 77 and also being known as PROPERTY OF NORMAN H. KEESEE & TINA J. KEESEE & recorded in Plat Book at Page and that the property lines, walls and buildings are as shown hereon, and that the walls and buildings located on said lot do not encroach or project on adjacent street or property, and thta no adjacent walls or buildings encroach or project on said premises, no power lines cross this property and no visible encroachments except a shown hereon.

33228

12-0-46

R. B. Bruce

R. B. Bruce, RLS # 1952

CAROLINA SURVEYING CO.
112 Manly St.
Greenville, S. C.

R. B. Bruce

Recordable Plat

301/33

P16.1-1-425

-----2 AP10 86 : 415