


This is to certify that on *MARCH, 31, 1986*, I surveyed the property shown on this plat, known as Lot 26 on the plat of Foxcroft, Map 1, Sec. 1, recorded in the RMC Office of Greenville County in Plat Book 4F on page 2 and that the property lines, walls and buildings are as shown hereon; that the building located on said lot does not encroach or project on adjacent streets or property and that no adjacent walls or buildings encroach or project on said premises, and that no utility lines cross this property except as shown hereon. This property is not located in a designated flood hazard area.

5' drainage and utility easement each side of all side and rear lot lines.

James R. Freeland
James R. Freeland PE and RLS

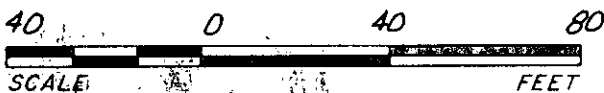

12-0-65 ✓ 33760 4781

STATE OF SOUTH CAROLINA
GREENVILLE COUNTY

FOXCROFT
MAP 1 ; SEC. 1 ; LOT 26
PROPERTY OF
JAMES R. GLENN
ELIZABETH M. GLENN

FREELAND & ASSOCIATES
Engineers • Land Surveyors

GREENVILLE, S.C.

SURVEY	J.E.C.
DRAWN	K.E.G.
CHECK	M.C.
SCALE	1" = 40'
DATE	3-31-86
DWG. NO.	14878

