



FILED
GREENVILLE CO. S. C.
APR 8 11 59 AM '86
JONNIE S. TANKERSLEY
R.M.C.

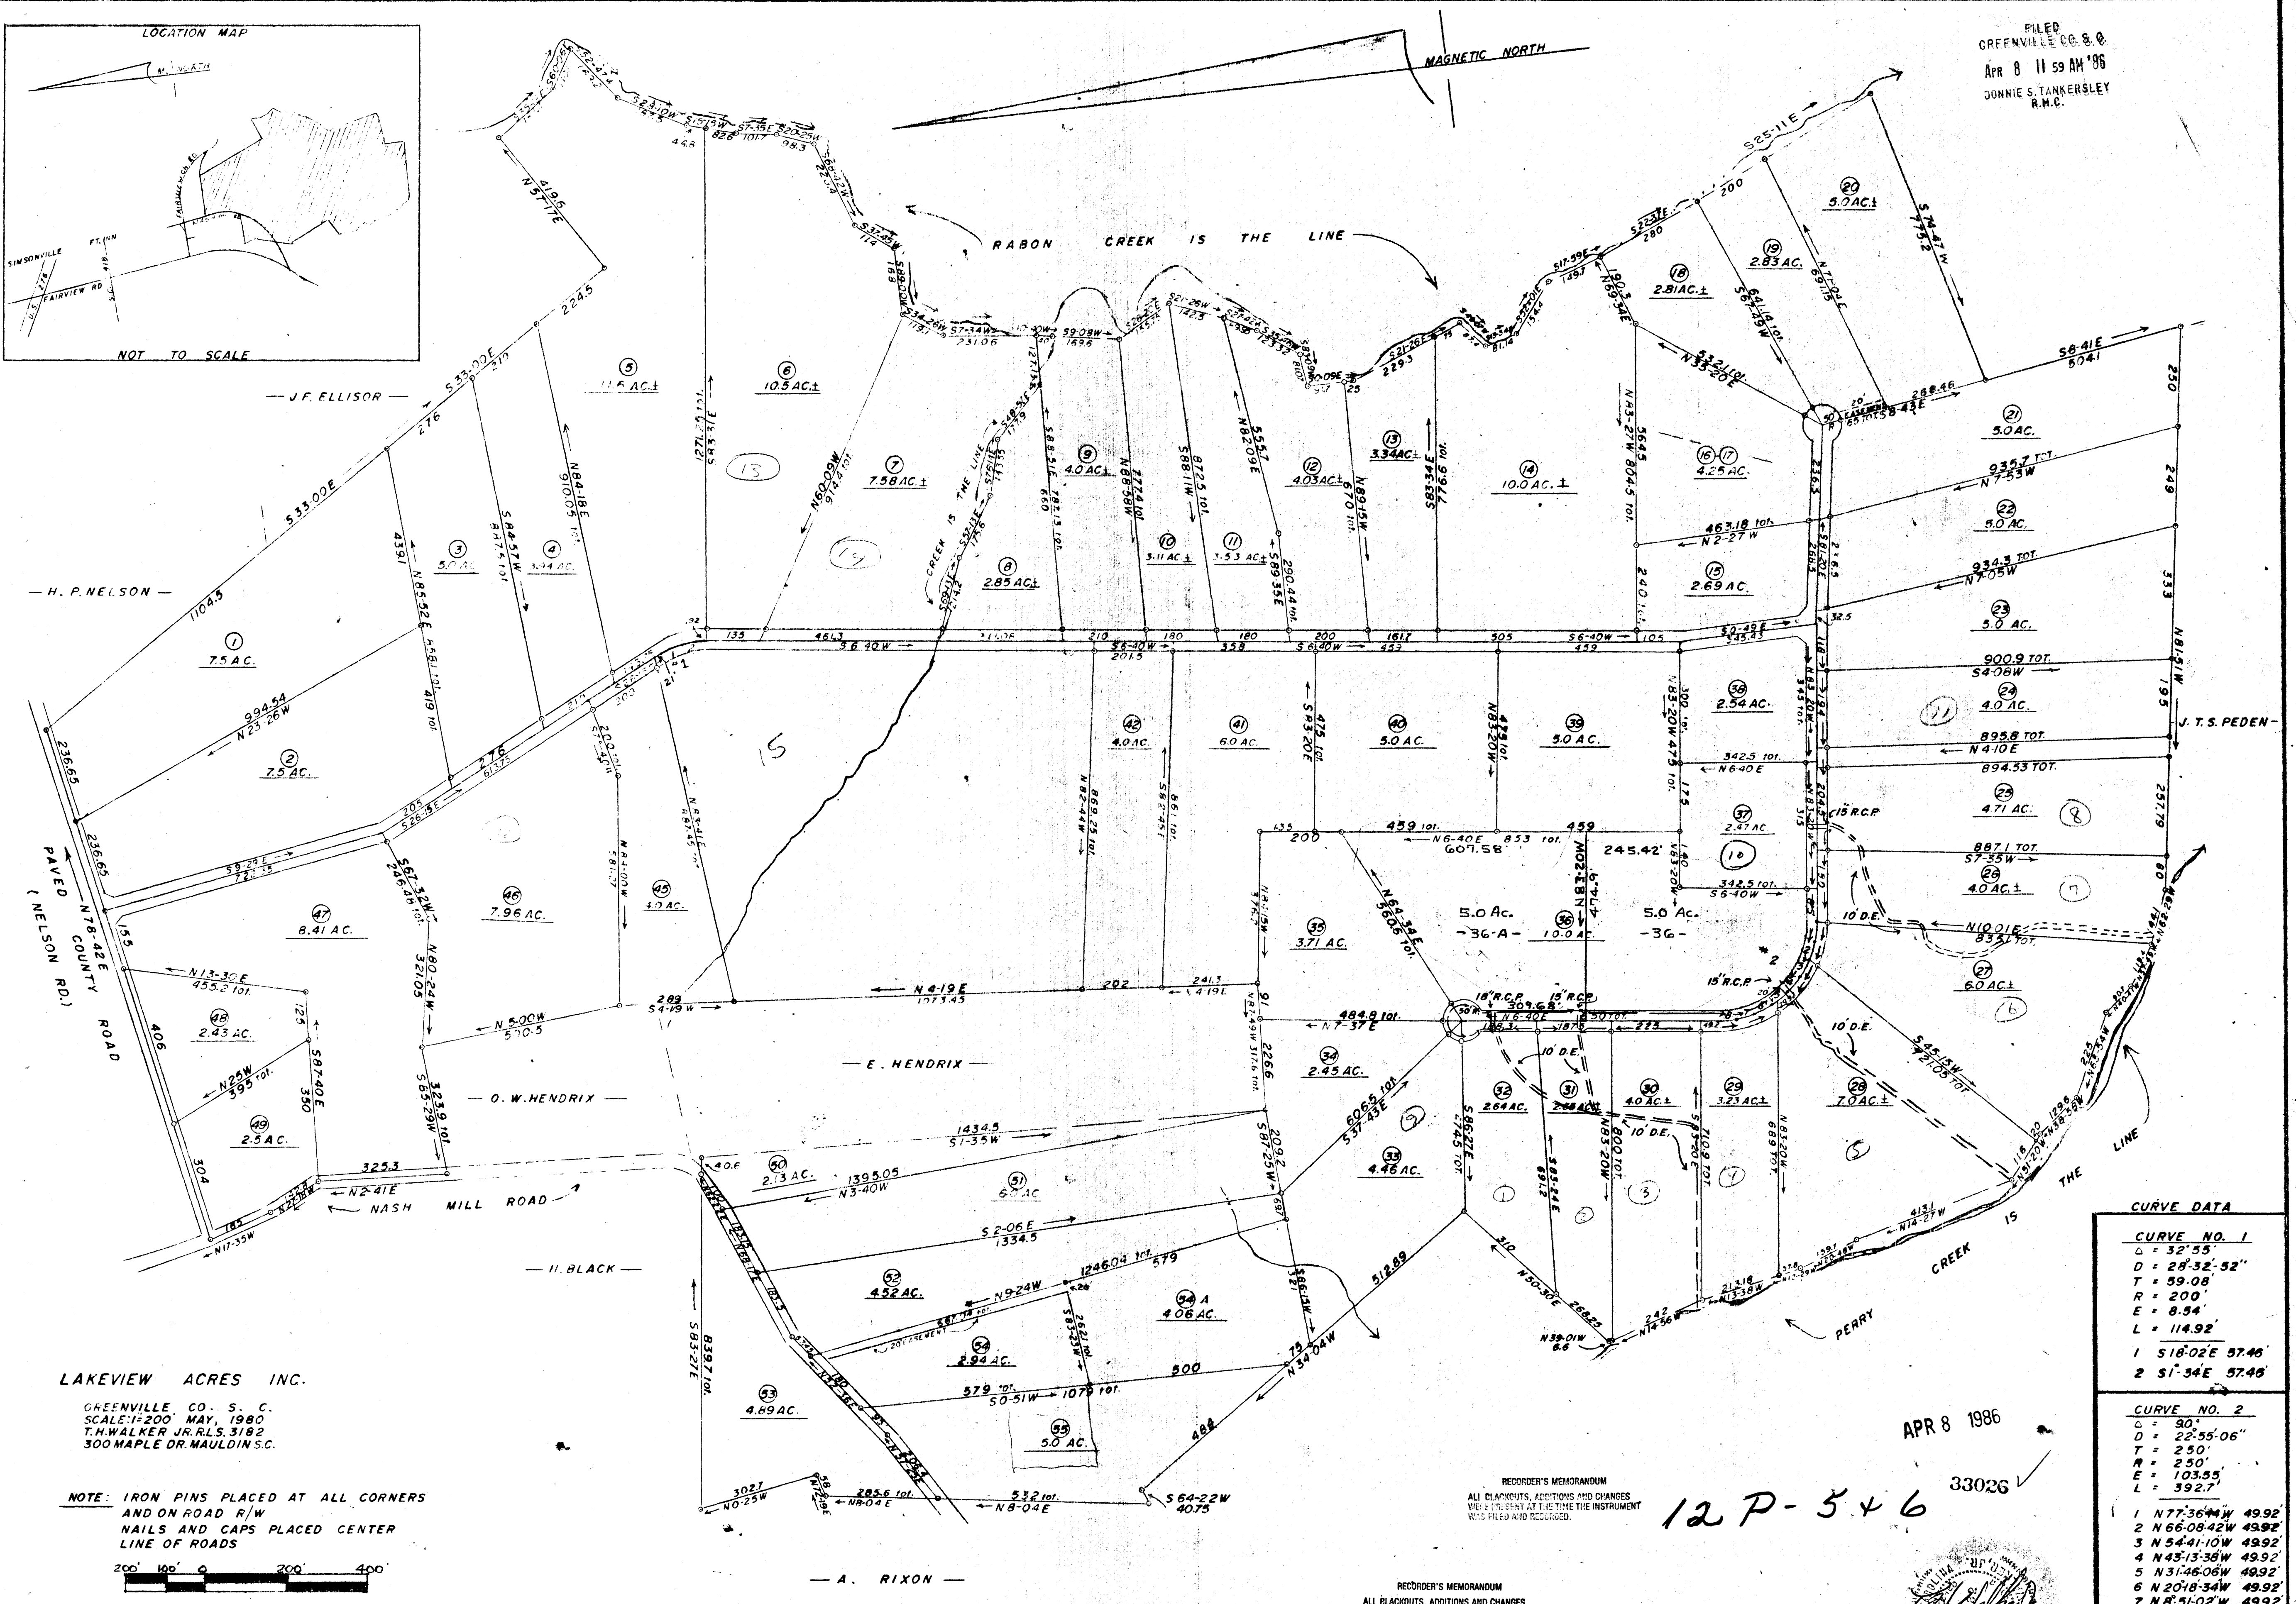

LAKEVIEW ACRES INC.
GREENVILLE CO. S. C.
SCALE: 1"=200' MAY, 1980
T.H. WALKER JR. R.L.S. 3182
300 MAPLE DR. MAULDIN S.C.

NOTE: IRON PINS PLACED AT ALL CORNERS AND ON ROAD R/W NAILS AND CAPS PLACED CENTER LINE OF ROADS

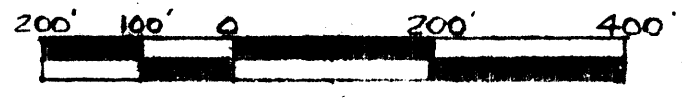

REFERENCE PLAT BY C.O. RIDDLE R.L.S. 1347
PREPARED FOR J.R. RICHARDSON JR. AUG. 1973
RECORDED IN PLAT BOOK 42 @ PAGE 81

REVISED 10-1-80 11-8-80 1-22-81 4-25-81 Lot 36 Revised 4-1-86.

RECORDER'S MEMORANDUM
ALL BLACKOUTS, ADDITIONS AND CHANGES WERE PRESENT AT THE TIME THE INSTRUMENT WAS FILED AND RECORDED.

RECORDER'S MEMORANDUM
ALL BLACKOUTS, ADDITIONS AND CHANGES WERE PRESENT AT THE TIME THE INSTRUMENT WAS FILED AND RECORDED.

CURVE DATA

CURVE NO. 1

Δ = 32°55'
D = 28°32'52"
T = 59.08'
R = 200'
E = 8.54'
L = 114.92'
1 S16°02'E 57.46'
2 S1°34'E 57.46'

CURVE NO. 2

Δ = 90°
D = 22°55'06"
T = 250'
R = 250'
E = 103.55'
L = 392.7'

- 1 N77°36'44"W 49.92'
- 2 N66°08'42"W 49.92'
- 3 N54°41'10"W 49.92'
- 4 N43°13'38"W 49.92'
- 5 N31°46'06"W 49.92'
- 6 N20°18'34"W 49.92'
- 7 N8°51'02"W 49.92'
- 8 N1°46'22"E 42.84'

12 P-546

APR 8 1986

33026



T.H. Walker Jr.

10.000