

FILED
GREENVILLE CO. S.C.
MAY 11 2 19 PM '86
MAG. NORTH
S. TANKERSLEY
R.M.C.

N 21-13 W 70.0


S 68-27 W 199.8

N 68-20 E 200.0
FENCE

13

12

11

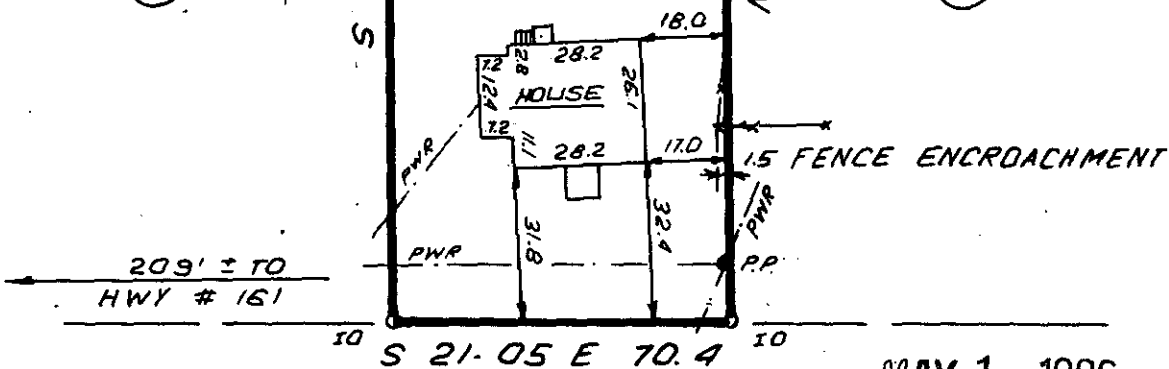

MAY 1 1986

MAYFIELD ROAD

12-Q-84

35953



THIS IS TO CERTIFY THAT THE PROPERTY SHOWN ON THIS PLAT WAS SURVEYED UNDER MY DIRECT SUPERVISION. PROPERTY LINES AND IMPROVEMENTS SHOWN ARE LOCATED CORRECTLY AND THAT NO VISIBLE ENCROACHMENTS EXIST UNLESS OTHERWISE SHOWN. THIS PROPERTY IS NOT LOCATED IN A DESIGNATED FLOOD HAZARD AREA



STATE OF SOUTH CAROLINA
GREENVILLE COUNTY

D.N. MAYFIELD ESTATE

LOT 12

PROPERTY OF

KRIS R. MARTIN

CHRIS H. MARTIN

FREELAND-CLINKSCALES
& ASSOCIATES, INC.

Engineers • Land Surveyors
323 WEST STONE AVENUE
GREENVILLE, S.C.
(803) 271-4924

PLAT BOOK CC-199

DEED BOOK 1245-228

TAX MAP 560.1-B-13

PARTY CHIEF J.C.C.

DRAWN I.R.

DATE APRIL-30-86

DWG. NO. 15129

RLS JAMES R. FREELAND
NO. 4781

ECTO 1 MY 186 027