


This is to certify that on APRIL 24, 1986 I surveyed the property shown on this plat, known as Property of Attalee W. Dill, recorded in the RMC Office of Greenville County in Deed Book 1051 on Page 2, and also recorded in Plat Book H on Page 164, and that the property lines, walls and buildings are as shown hereon; that the building located on said lot does not encroach or project on adjacent streets or property, and that no adjacent walls or buildings encroach or project on said premises, and that no utility lines cross this property except as shown hereon. This property is not located in a designated flood hazard area.

James R. Freeland
 James R. Freeland RLS & PE 4781

FILED
 GREENVILLE CO. S.C.
 APR 30 10 17 AM '86
 DONNIE S. TANKERSLEY
 R.M.C.

12-R-12
 35739
 scale 0 20 40 feet

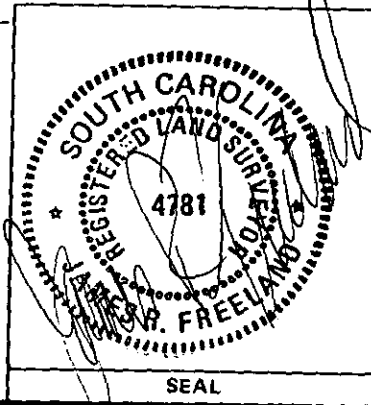

STATE OF SOUTH CAROLINA
 GREENVILLE COUNTY

PROPERTY OF
JOHN D. Mc CALL JR.
ANNA W. Mc CALL

| | |
|---|-------------|
| FREELAND & ASSOCIATES Engineers • Land Surveyors GREENVILLE, S.C. | |
| SURVEY | J.G. |
| DRAWN | B.R. |
| CHECK | MLC |
| SCALE | 1" = 20' |
| DATE | APRIL 24 86 |
| DWG. NO. | 15088 |