


GREENVILLE CC. S. C.
 APR 30 11 42 AM '86
 JOHNNIE S. TANKERSLEY
 R.M.C.

MAG 1937

Note: Improvements on this lot are not in a flood hazard area.

GRACE STREET
 WATER & SEWER IN ST. RW.

PROPERTY OF
 HELEN SHERMAN WILSON
 CITY OF GREENVILLE, S. C.
 SCALE 1" = 20' 14 APRIL 1986

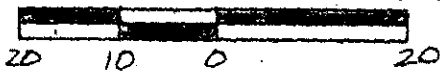


APR 30 1986

12-R-13

35729 ✓

This is to certify that on the 14th day of April, 1986, I surveyed the property shown on this plat, being known as lots 19 & 20 on plat of PROPERTY OF CHARLES WATSON & MRS. GRACE WATSON GRIFFITH and recorded in the RMC Office Greenville County, S. C., in Plat Book " G " at Pages 164 & 165; and that the property lines, walls and buildings are as shown hereon, and that walls and buildings located on said lot do not encroach or project on adjacent street or property, and that no adjacent walls or buildings encroach or project on said premises, no power lines cross this property and no visible encroachments except as shown hereon.

R. B. Bruce
 R. B. Bruce

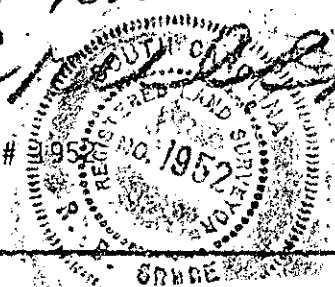

CAROLINA SURVEYING CO.
 Greenville, S. C.

R. B. Bruce, RLS #

GCTO ----- 1 AP29 86 058

5.0000

303/46

74-6-1