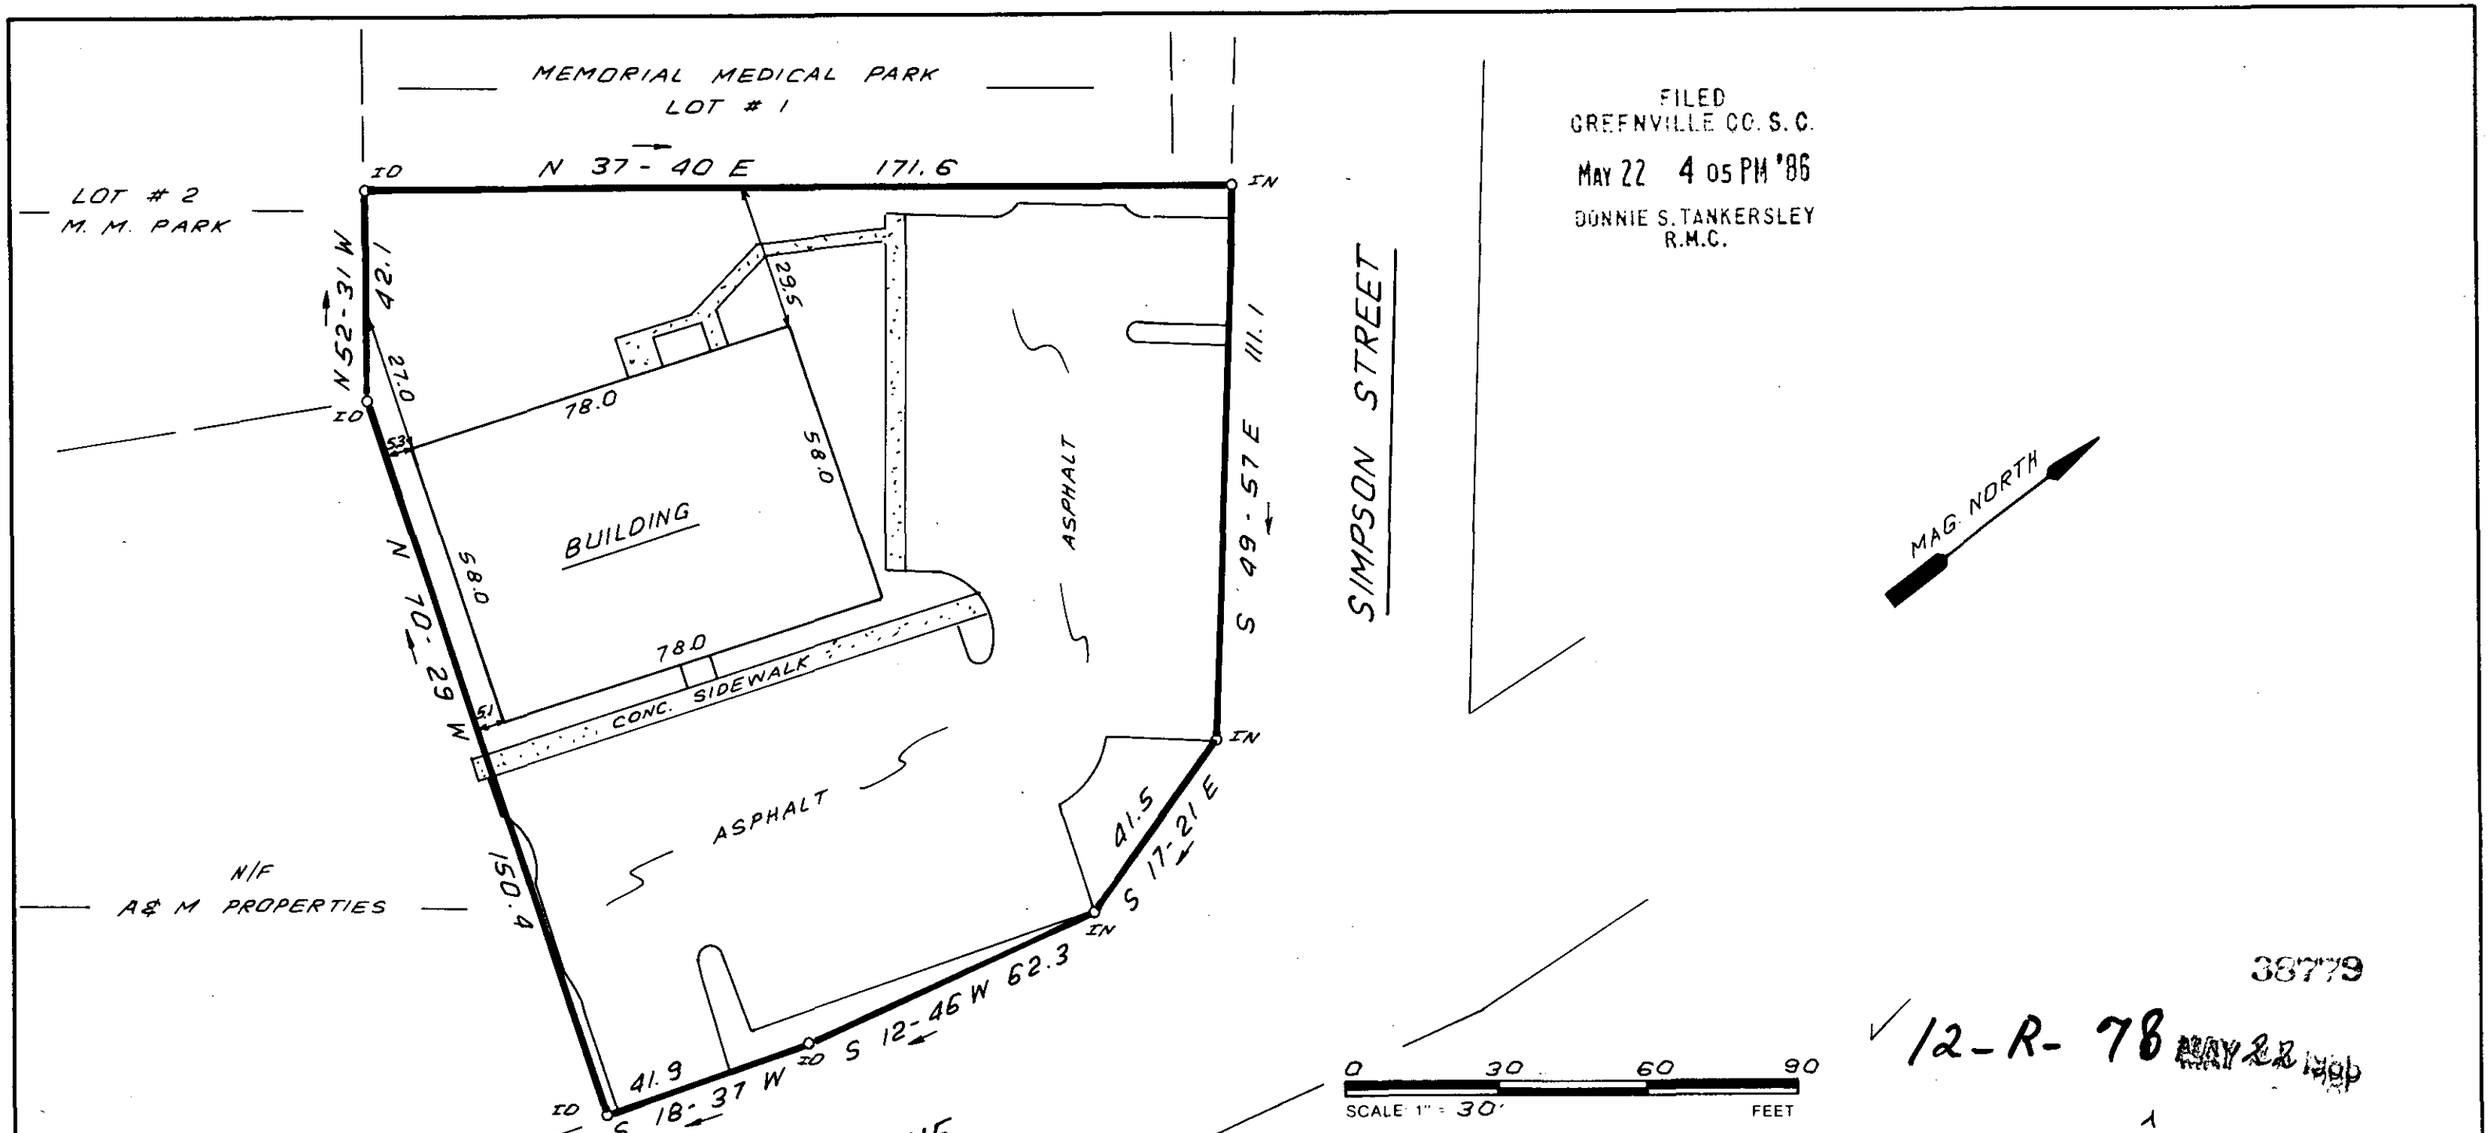

FILED
GREENVILLE CO. S.C.
MAY 22 4 05 PM '86
DONNIE S. TANKERSLEY
R.M.C.

38779

✓ 12-R-78 MAY 22 1986

THIS IS TO CERTIFY THAT THE PROPERTY SHOWN ON THIS PLAT WAS SURVEYED UNDER MY DIRECT SUPERVISION. PROPERTY LINES AND IMPROVEMENTS SHOWN ARE LOCATED CORRECTLY AND THAT NO VISIBLE ENCROACHMENTS EXIST UNLESS OTHERWISE SHOWN. THIS PROPERTY IS NOT LOCATED IN A DESIGNATED FLOOD HAZARD AREA.

SOUTH CAROLINA REGISTERED PROFESSIONAL ENGINEER AND LAND SURVEYOR No. 4781 JAMES R. FREELAND

RLS: JAMES R. FREELAND
NO: 4781

STATE OF SOUTH CAROLINA
GREENVILLE COUNTY

PROPERTY OF
DONALD W. SHELLEY

GCTC -- 3 MY22 86 190

FREELAND & ASSOCIATES
Engineers • Land Surveyors
318 WEST STONE AVENUE.
GREENVILLE, S.C.
(803) 271-4924

PLAT BOOK	
DEED BOOK	1194-372,373
TAX MAP	102-2-1.7
PARTY CHIEF	J.C.
DRAWN	I.R.
DATE	MAY-20-86
DWG. NO.	15285

MICROFILMED
THE PRINT MACHINE, INC. N41289