


FILED
 GREENVILLE CO. S. C.
 MAY 27 12 28 PM '86
 NOTES: IRON PINS AT ALL PROPERTY CORNERS. JONNIE S. TANKERSLEY
 R.M.C.

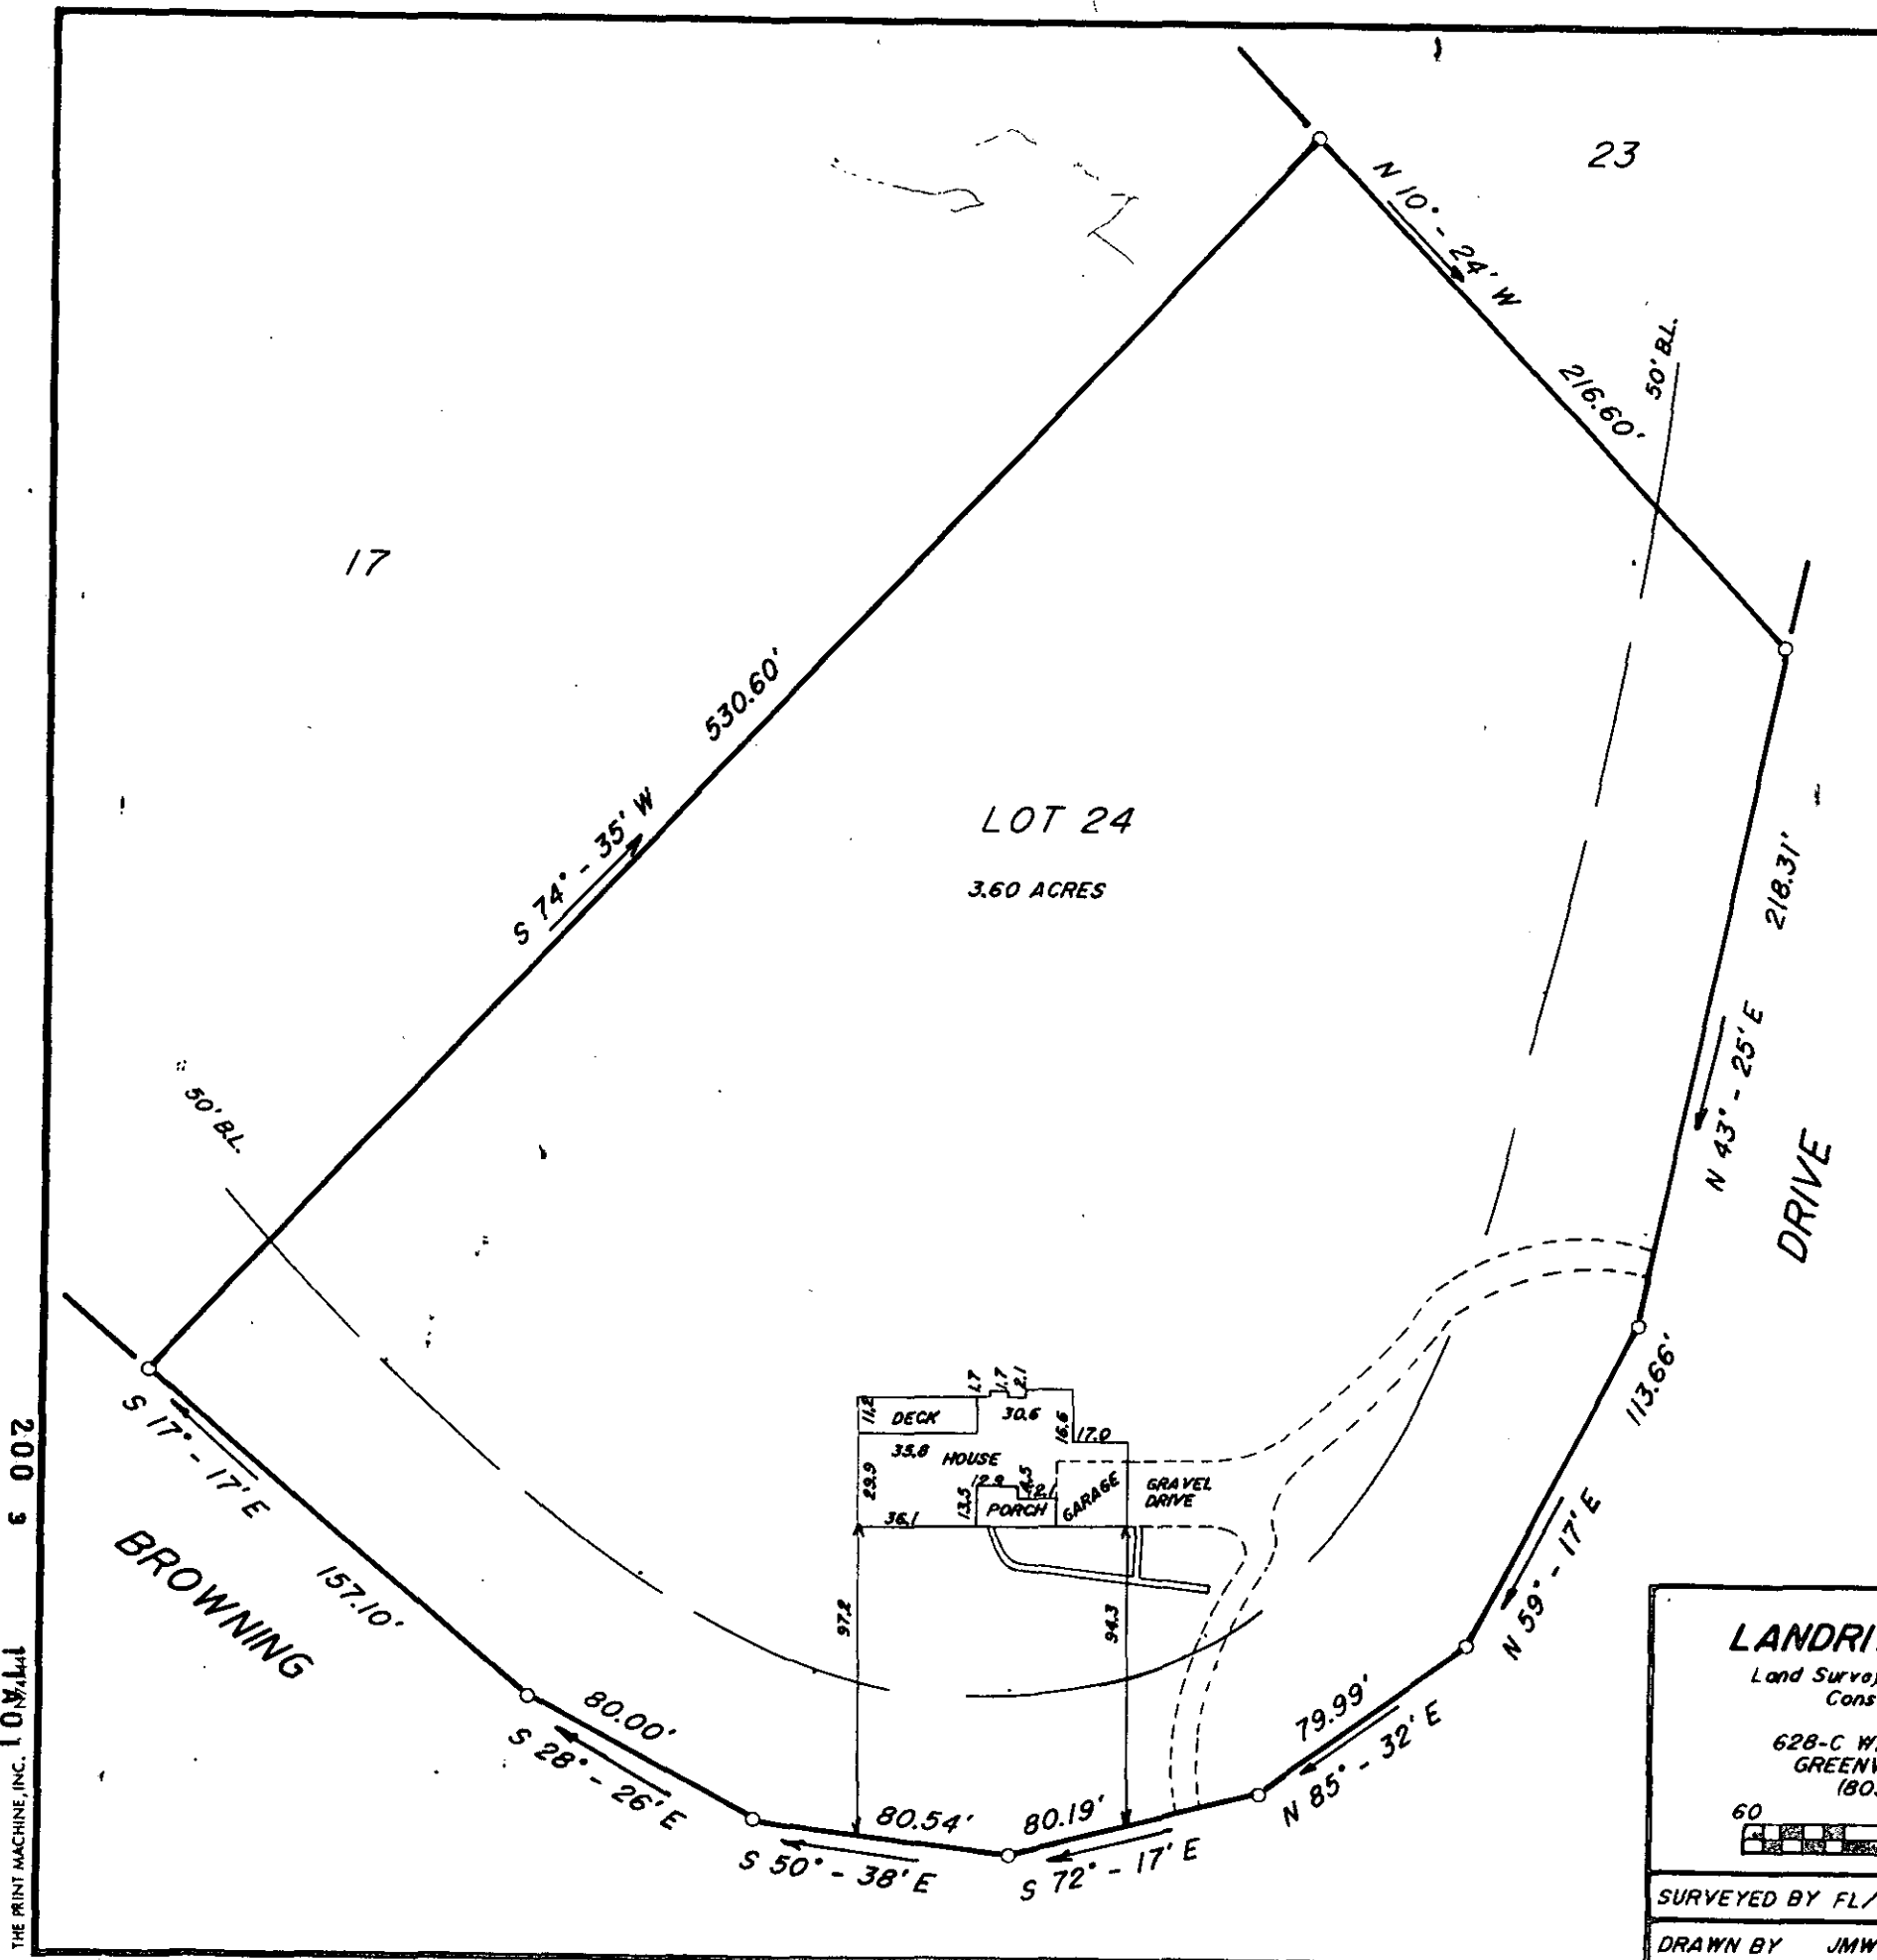

This is to certify that on May 15, 1986, I surveyed the property shown on this plat, known as Lot 24 on plat of Boiling Springs Estates, recorded in the R.M.C. Office of Greenville County, in Plat Book YY at Page 14 and 15, and that the property lines, walls and buildings are as shown hereon, that the building located on said lot does not encroach or project on adjacent streets or property, and that no adjacent walls or buildings encroach or project on said premises, and that no utility R/W's cross this property except as shown hereon. According to the Flood Rate Insurance Map and to the best of my knowledge, this structure is not in an Established Flood Zone.

Fredrick E. Landrith
 Fredrick E. Landrith RLS 9545
 39220
 Recordable plat 12-R-84 MAY 27 1986

THIS PROPERTY IS SUBJECT TO ANY AND ALL RIGHTS OF WAY AND EASEMENTS OF RECORD.

LANDRITH SURVEYING Land Surveys - Topographical Maps Construction Layout 628-C WADE HAMPTON BLVD. GREENVILLE, S.C. 29609 (803) 271-8536 			STATE of SOUTH CAROLINA COUNTY of GREENVILLE
SURVEYED BY FL/ES DRAWN BY JMW	CHK'D BY JMW DATE 05/15/86		BOILING SPRINGS ESTATES LOT 24 SURVEY FOR ROBERT ROSS DIANA W. ROSS
		SEAL	PROJECT NO. 7586 - 742 3.00 CI

200 3
 THE PRINT MACHINE, INC. 177X01

MICROFILMED