


Note:  
Improvements on this lot are not in a flood hazard area.

REF: SURVEY FOR JAMES M. BERRY, 10.0 AC., DATED 29 JUNE 1984. GAS LINE R/W INFO FROM MAP B OF 23, COLONIAL GAS LINE LOC. 702.

FILED  
GREENVILLE CO. S.C.  
MAY 29 12 26 PM '86  
JOHNNIE S. TANKERSLEY  
R.M.C.

PROPERTY OF  
**JAMES MICHAEL BERRY & DEBORAH B. BERRY**  
NEAR GREENVILLE, GREENVILLE CO, S.C.  
SCALE: 1"=60' 1 MAY 1986

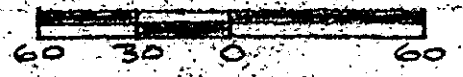

This is to certify that on the 1st day of May, 1986, I surveyed the property shown on this plat, being known as 4.0 acres on plat of JAMES M. BERRY and recorded in the RMC Office Greenville County, S. C., in Plat Book " 10 - W " at Page 16 and also known as PROPERTY OF JAMES MICHAEL BERRY & DEBORAH B. BERRY and recorded in Plat Book \_\_\_\_\_ at Page \_\_\_\_\_; and that the property lines, walls and buildings are as shown hereon, and that the walls and buildings located on said lot do not encroach or project on adjacent street or property, and that no adjacent walls or buildings encroach or project on said premises, no power lines cross this property and no visible encroachments except as shown hereon.

12-R-92

39644

R. B. Bruce

R. B. Bruce, RLS # 1952



CAROLINA SURVEYING CO.  
112 Manly St.  
Greenville, S.C.

Recordable Plat

587.3-1-2.1

(193229)

31A01