Note: Improvements on this lot are not in a flood hazard area.

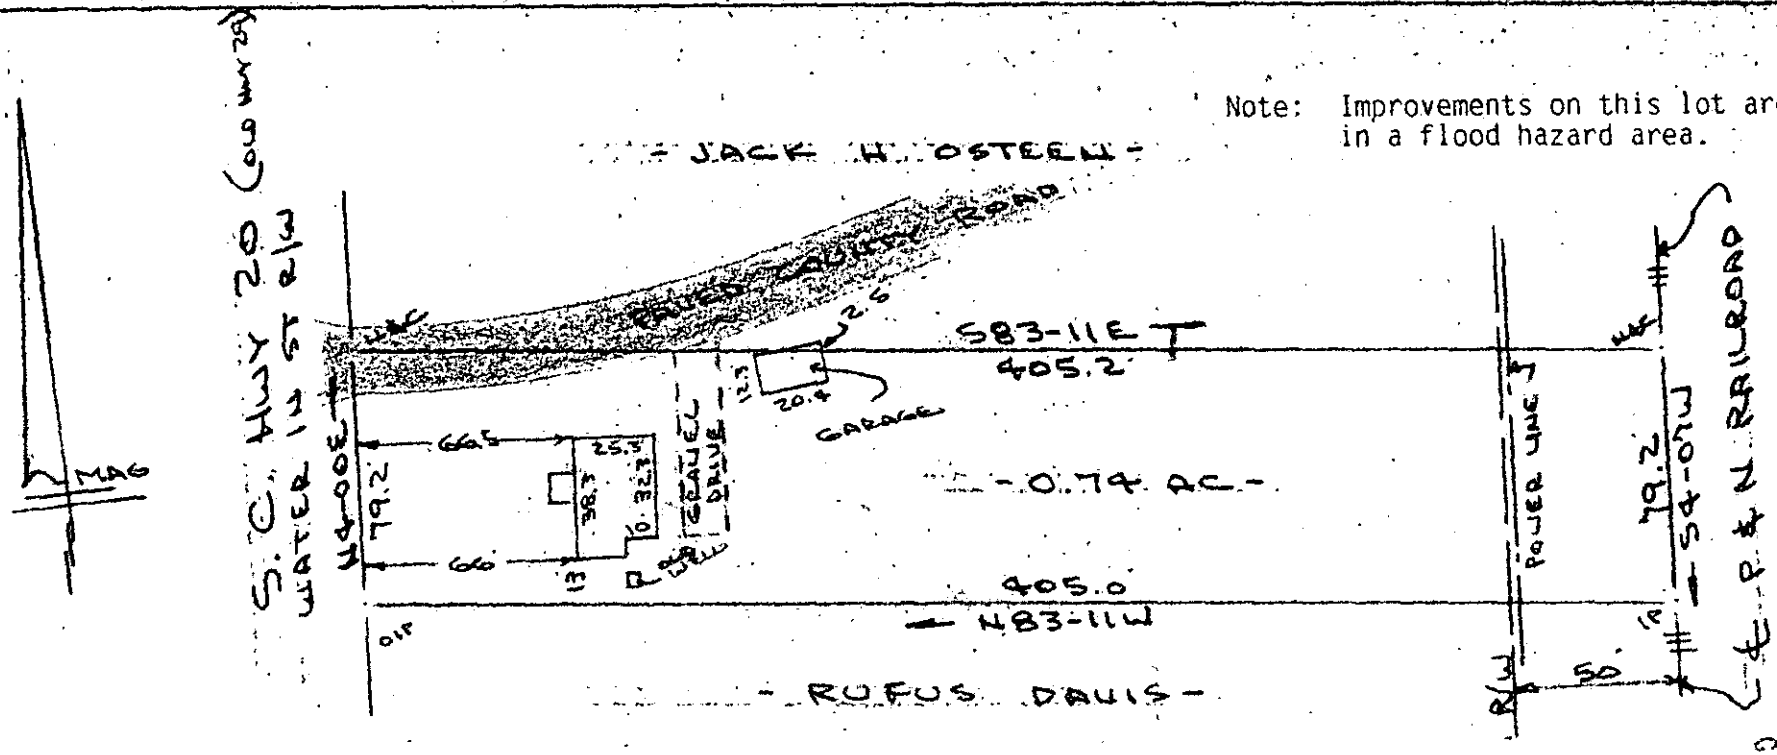

PROPERTY OF
WILLIAM RALPH WEEDON, JR. & CYNTHIA M. PAYNE
NEAR PIEDMONT, GREENVILLE CO., S.C.
SCALE: 1" = 60 15 MAY 1986

60 30 0 60

This is to certify that on the 15th day of May, 1986, I surveyed the property shown on this plat being known as 0.74 acre on plat of PROPERTY OF WILLIAM RALPH WEEDON, JR. & CYNTHIA M. PAYNE and recorded in the RMC Office Greenville County, S. C., in Plat Book " " at Page ; and that the property lines, walls and buildings are as shown hereon, and that the walls and buildings located on said lot do not encroach or project on adjacent street or property, and that no adjacent walls or buildings encroach or project on said premises, no power lines cross this property and no visible encroachments except as shown hereon.

MAY 16 1986 12-8-65 37952 R. B. Bruce

R. B. Bruce RLS # 1952

CAROLINA SURVEYING CO.
112 Manly St.
Greenville, S. C.

FILED
GREENVILLE CO. S.C.
MAY 16 10 46 AM '86
DONNIE S. TANKERSLEY
R.M.C.

Recordable Plat

MICROFILMED

307/7 & 8A 610.1-1-3 3 MY16 86 950 3.00CI