


FILED
 GREENVILLE CO. S. C.
 MAY 16 4 04 PM '86
 JUNNIE S. TANKERSLEY
 R.M.C.

SHADOW WAY

12-8-74

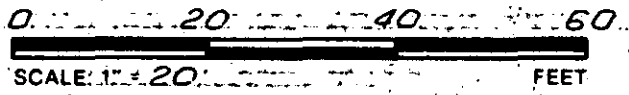

MAY 16 1986 38071

THIS IS TO CERTIFY THAT THE PROPERTY SHOWN ON THIS PLAT WAS SURVEYED UNDER MY DIRECT SUPERVISION. PROPERTY LINES AND IMPROVEMENTS SHOWN ARE LOCATED CORRECTLY AND THAT NO VISIBLE ENCROACHMENTS EXIST UNLESS OTHERWISE SHOWN. THIS PROPERTY IS NOT LOCATED IN A DESIGNATED FLOOD HAZARD AREA.

SOUTH CAROLINA
 REGISTERED
 LAND SURVEYOR
 No. 4781
 RALPH FREELAND

RLS: JAMES R. FREELAND
 NO: 4781

STATE OF SOUTH CAROLINA
 GREENVILLE COUNTY

1200 PELHAM
PHASE 1, SEC. 3, LOT 14
 PROPERTY OF
DONALD R. Mc ALISTER
JUDY B. Mc ALISTER

FREELAND-CLINKSCALES & ASSOCIATES, INC.
 Engineers • Land Surveyors
 323 WEST STONE AVENUE
 GREENVILLE, S.C.
 (803) 271-4924

PLAT BOOK	9 W-58
DEED BOOK	
TAX MAP	
PARTY CHIEF	R. J.
DRAWN	I. R.
DATE	MAY-14-86
DWG. NO.	15218