


FILED  
GREENVILLE CO. S.C.  
MAY 19 4 29 PM '86  
JONNIE S. TANKERSLEY  
R.M.C.

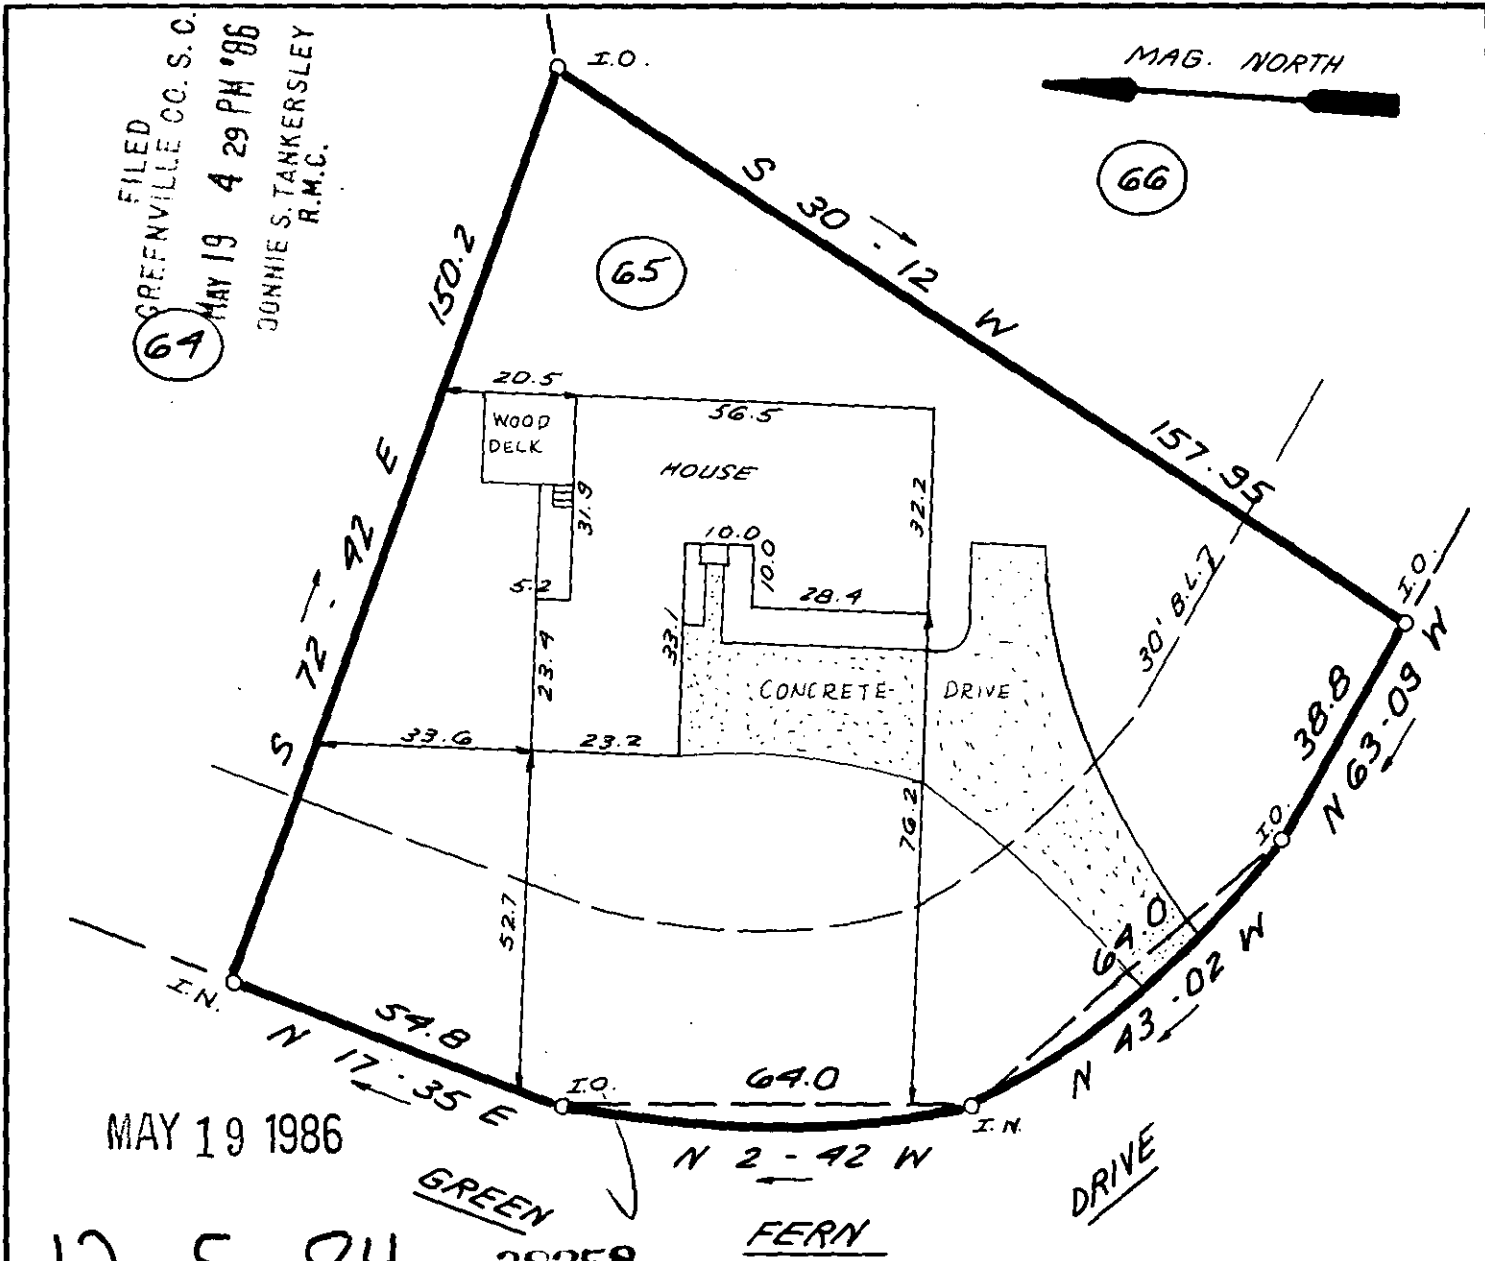

MAY 19 1986


12-5-84

38258



NOTE: THERE IS A 5' UTILITY AND DRAINAGE EASEMENT ALONG ALL SIDE AND REAR LOT LINES.

THIS IS TO CERTIFY THAT THE PROPERTY SHOWN ON THIS PLAT WAS SURVEYED UNDER MY DIRECT SUPERVISION. PROPERTY LINES AND IMPROVEMENTS SHOWN ARE LOCATED CORRECTLY AND THAT NO VISIBLE ENCROACHMENTS EXIST UNLESS OTHERWISE SHOWN. THIS PROPERTY IS NOT LOCATED IN A DESIGNATED FLOOD HAZARD AREA.

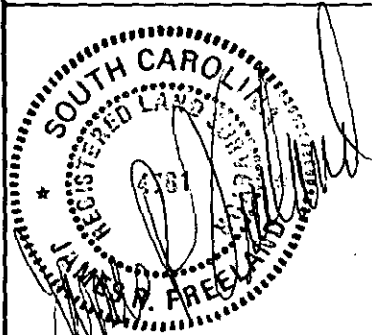

**STATE OF SOUTH CAROLINA  
GREENVILLE COUNTY**

**FREELAND & ASSOCIATES**  
Engineers • Land Surveyors  
318 WEST STONE AVENUE  
GREENVILLE, S.C.  
(803) 271-4924

WHITE OAK HILLS  
SEC. III ; LOT 65  
PROPERTY OF  
STEVEN E. THRAILKILLE  
LYNNE C. THRAILKILLE

PLAT BOOK	7X-56
DEED BOOK	1207-252
TAX MAP	B 4.6-1-125
PARTY CHIEF	J.E.C.
DRAWN	K.E.G.
DATE	5-13-86
DWG. NO.	1523.00CI

RLS: JAMES R. FREELAND  
NO: 4781