

FILED
 GREENVILLE CO. S.C.
 MAY 23 1986 PM 1:05
 JONNIE S. TANKERSLEY
 R.M.C.

This is to certify that on May 14, 1986, I surveyed the property shown on this plat, known as Lot 243 on plat of Property of Robert J. Edwards, recorded in the R.M.C. Office of Greenville County, in Plat Book 9I at Page 83, and that the property line, walls and buildings are as shown hereon, that the building located on said lot does not encroach or project on adjacent streets or property, and that no adjacent walls or buildings encroach or project on said premises, and that no utility P/W's cross this property, except as shown hereon. According to the Flood Rate Insurance Map and to the best of my knowledge, this structure is not in an Established Flood Zone.

#38955 ✓

Recordable plat

Fredrick E. Landrith

Fredrick E. Landrith 9545


12-T-15

THIS PROPERTY IS SUBJECT TO ANY AND ALL RIGHTS OF WAY AND EASEMENTS OF RECORD

LANDRITH SURVEYING

Land Surveys - Topographical Maps
 Construction Layout

628-C WADE HAMPTON BLVD.
 GREENVILLE, S.C. 29609
 (803) 271-8536

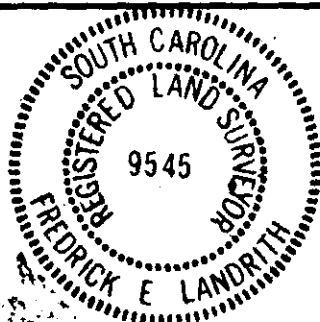

**STATE of SOUTH CAROLINA
 COUNTY of GREENVILLE**

PROPERTY OF
ROBERT J. EDWARDS
 LOT 243
 SURVEY FOR

**JOHN O. CRAWFORD, III
 SANDRA C. CRAWFORD**

SURVEYED BY FLA/ES	CHK'D BY JMW
DRAWN BY TLM	DATE 05/14/86

SEAL

PROJECT NO. 86 - 741