


FILED
GREENVILLE CO. S. C.

MAY 30 4 28 PM '86

DONNIE S. TANKERSLEY
R.M.C.

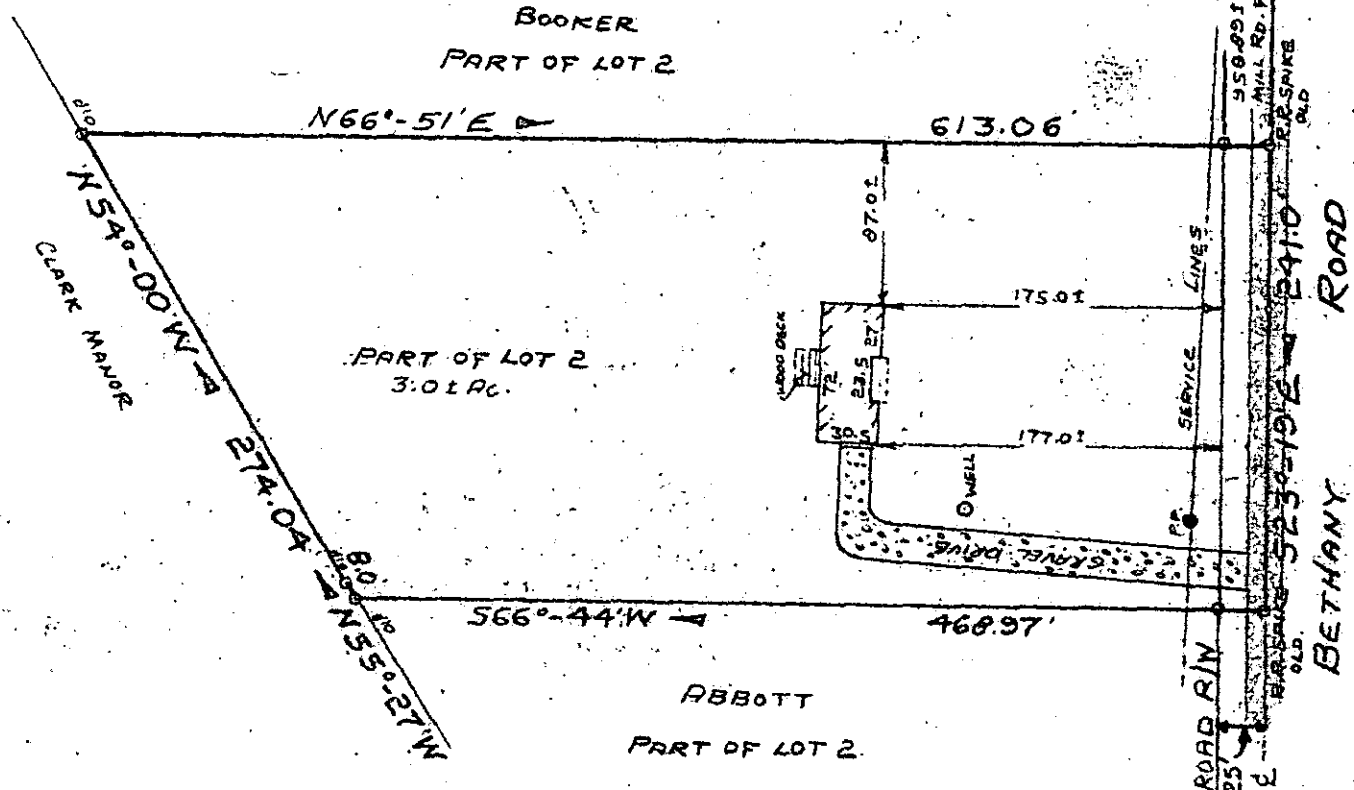

PROPERTY OF
CHARLES RAY BARRETT
 AND
DEBRA C. BARRETT
 GREENVILLE COUNTY, SOUTH CAROLINA
 MAY 26, 1986 SCALE 1"=100'

39908 ✓

MAY 30 1986

12-T-75

This is to certify that on May 26, 1986, I surveyed the property shown on this plat known as part of Lot 2, FANNIE C. COOPER EST. as recorded in the RMC Office for Greenville County, in Plat Book 5-X at page 40, also known as a 3.0-acre tract of PROPERTY OF VERNON COOPER, as recorded in Plat Book 9-U, Page 75, and that the property lines, walls, and buildings are as shown hereon, and that the building located on said lot does not project nor encroach on adjacent streets or property, and that no adjacent walls or buildings project nor encroach on said lot, and that no utility lines cross this property except as may be shown hereon.

NOTE: This property is not located within a flood hazard area.

Survey by: *Richard D. Coates*
 Greenville, South Carolina
 S. C. R. L. S. No. 1401

RECORDABLE PLAT

MICROFILMED