MICROFILMED

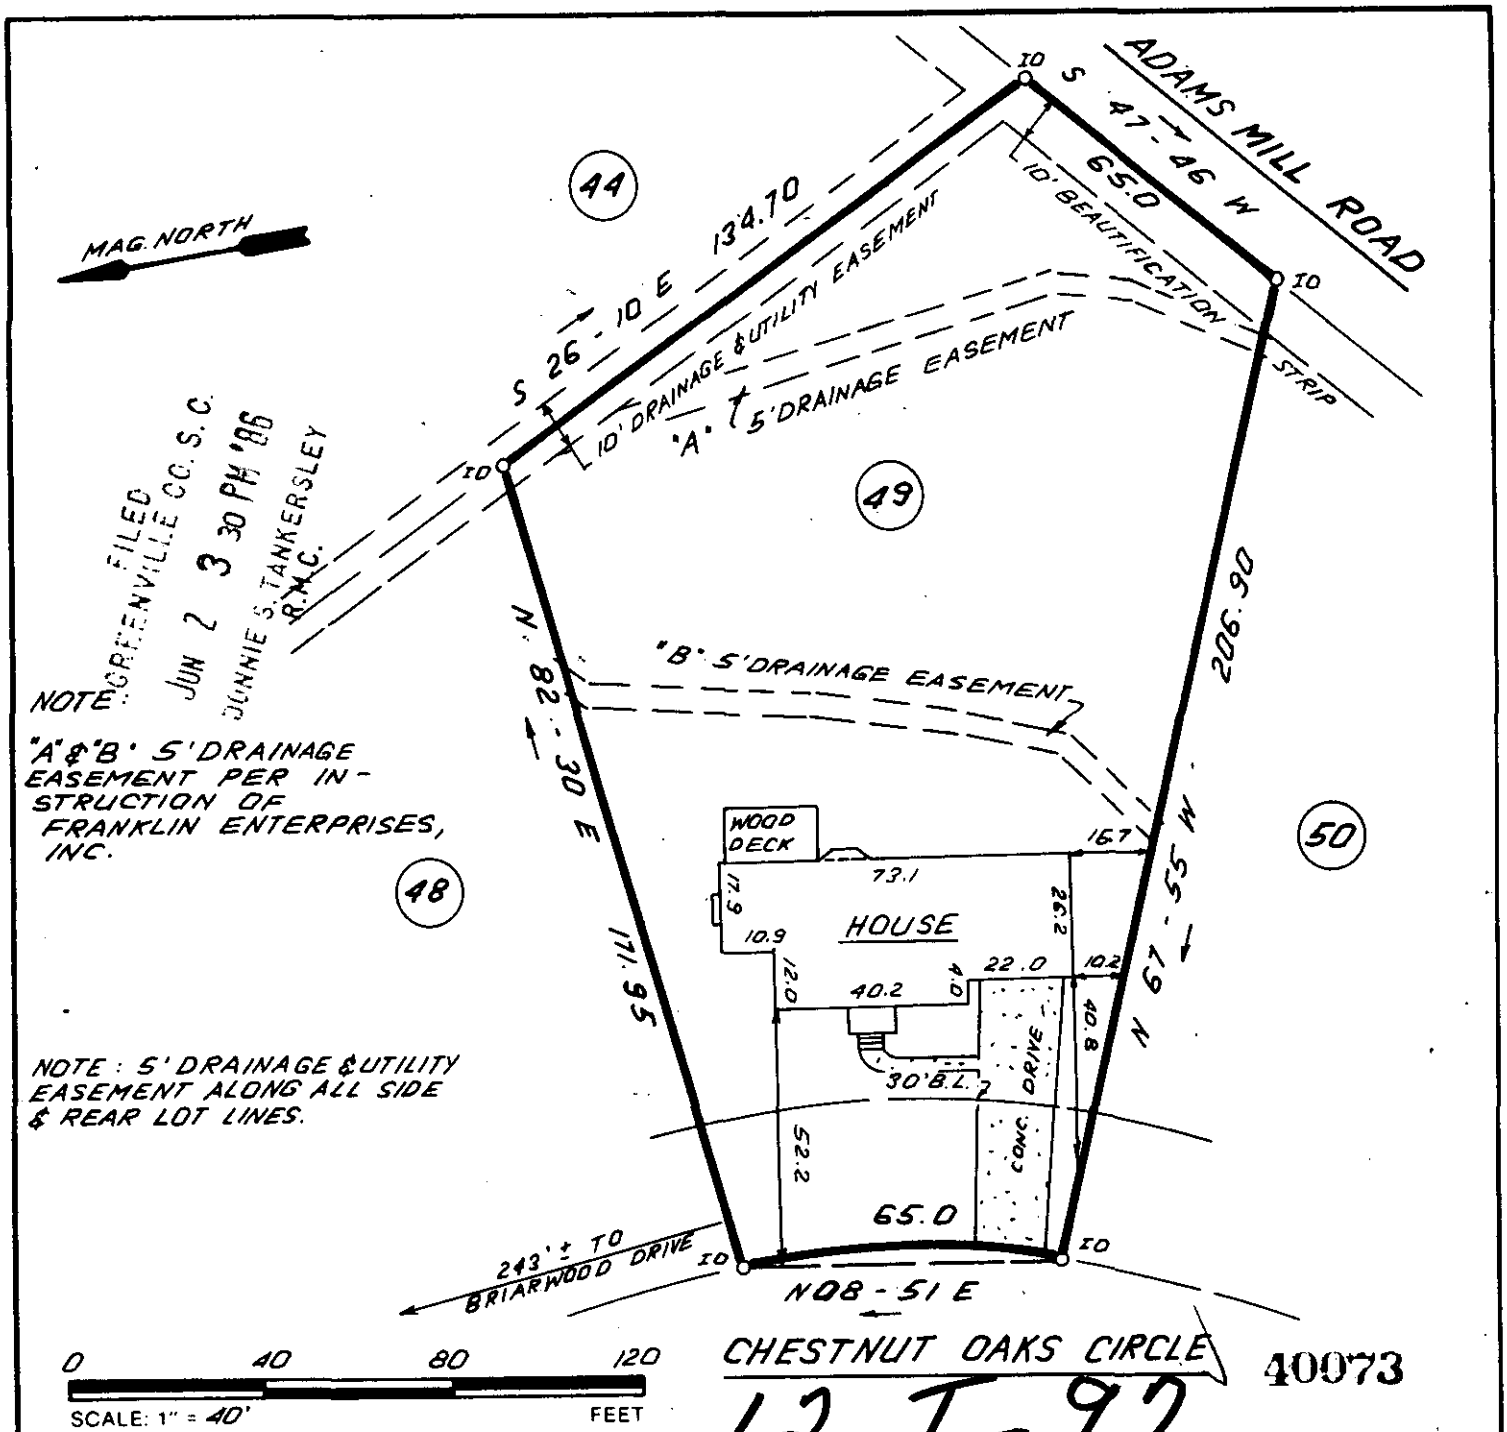

FILED
GREENVILLE CO. S.C.
JUN 2 3 30 PM '86
DONNIE S. TANKERSLEY
R.M.C.

NOTE:
"A" & "B" 5' DRAINAGE EASEMENT PER INSTRUCTION OF FRANKLIN ENTERPRISES, INC.

NOTE: 5' DRAINAGE & UTILITY EASEMENT ALONG ALL SIDE & REAR LOT LINES.

40073

12-T-92

THIS IS TO CERTIFY THAT THE PROPERTY SHOWN ON THIS PLAT WAS SURVEYED UNDER MY DIRECT SUPERVISION PROPERTY LINES AND IMPROVEMENTS SHOWN ARE LOCATED CORRECTLY AND THAT NO VISIBLE ENCROACHMENTS EXIST UNLESS OTHERWISE SHOWN. THIS PROPERTY IS NOT LOCATED IN A DESIGNATED FLOOD HAZARD AREA

SOUTH CAROLINA REGISTERED PROFESSIONAL ENGINEER AND LAND SURVEYOR No. 4781 JAMES R. FREELAND

RLS: JAMES R. FREELAND
NO: 4781

STATE OF SOUTH CAROLINA
GREENVILLE COUNTY

HOLLY TREE PLANTATION
PHAS III ; SEC. II ; LOT 49
PROPERTY OF
JAMES A. BRUORTON
LINDA A. BRUORTON

FREELAND & ASSOCIATES
Engineers • Land Surveyors
318 WEST STONE AVENUE
GREENVILLE, S.C.
(803) 271-4924

PLAT BOOK	7C-27
DEED BOOK	1237 - 917
TAX MAP	548.3-1-68
PARTY CHIEF	R.J.
DRAWN	I.R.
DATE	MAY-29-86
DWG NO.	15360

THE PRINT MACHINE, INC. N48640

(12862)