



FILED
GREENVILLE CO. S. C.
JUN 10 2 43 PM '86
JONNIE S. TANKERSLEY
R.M.C.

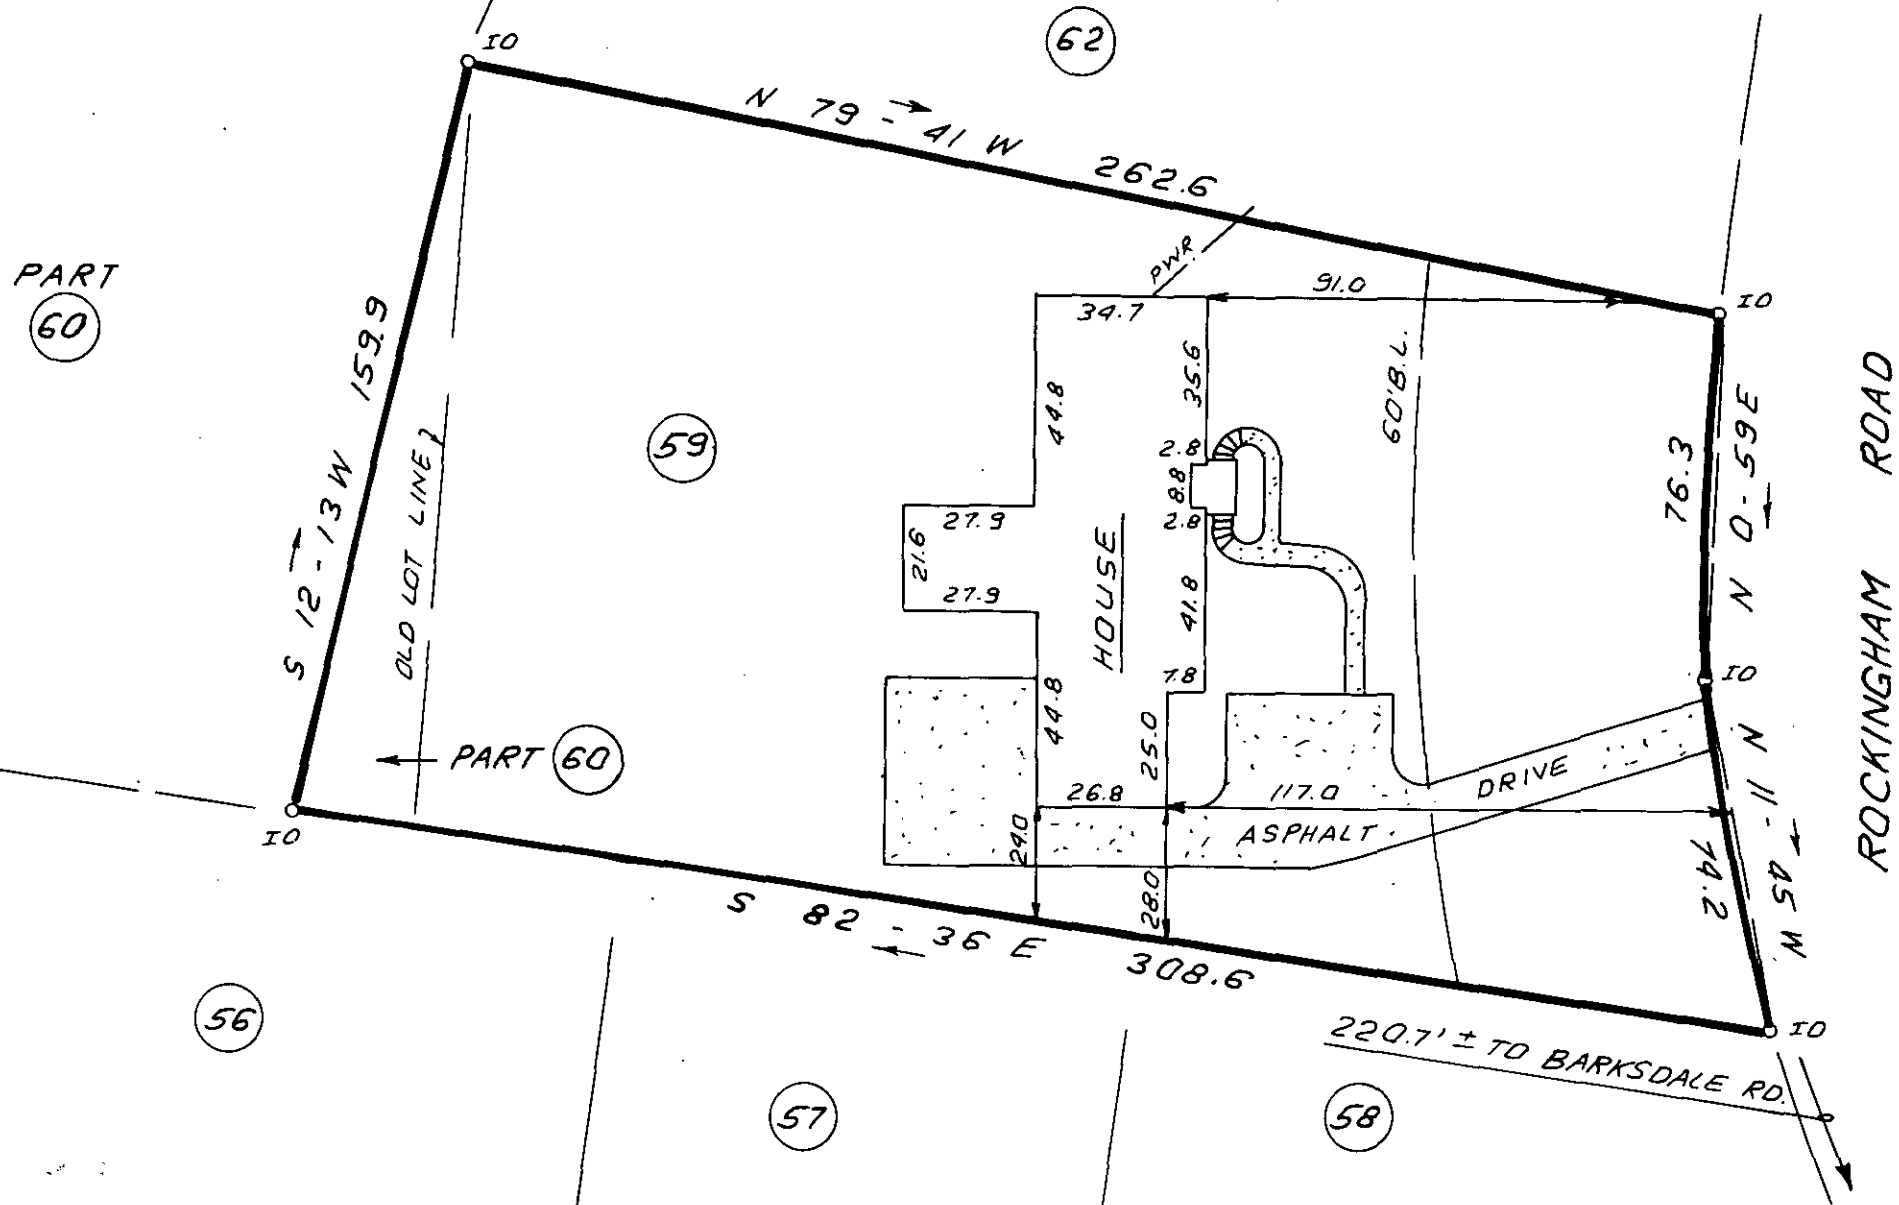

41316
12. U. 32 JUN 10 1986

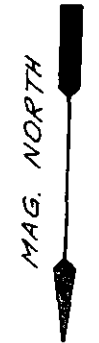

THIS IS TO CERTIFY THAT THE PROPERTY SHOWN ON THIS PLAT WAS SURVEYED UNDER MY DIRECT SUPERVISION PROPERTY LINES AND IMPROVEMENTS SHOWN ARE LOCATED CORRECTLY AND THAT NO VISIBLE ENCROACHMENTS EXIST UNLESS OTHERWISE SHOWN. THIS PROPERTY IS NOT LOCATED IN A DESIGNATED FLOOD HAZARD AREA.

NOTE: 5' DRAINAGE & UTILITY EASEMENT ALONG EACH SIDE OF ALL SIDE & REAR LOT LINES.

SOUTH CAROLINA
REGISTERED PROFESSIONAL ENGINEER AND LAND SURVEYOR
JAMES R. FREELAND
NO. 4781

**STATE OF SOUTH CAROLINA
GREENVILLE COUNTY**

**BARKSDALE
LOT 59 & PT. LOT 60
PROPERTY OF
M. BAKER WYCHE III
MARGUERITE R. WYCHE**

FREELAND & ASSOCIATES
Engineers • Land Surveyors
318 WEST STONE AVENUE,
GREENVILLE, S.C.
(803) 271-4924

PLAT BOOK	QQ - 119
DEED BOOK	741 - 68
TAX MAP	M 15.4-1-64
PARTY CHIEF	J.C.C.
DRAWN	I.R.
DATE	MAY - 29 - 86
DWG. NO.	15358