



FILED
GREENVILLE CO. S. C.
JUN 24 9 13 AM '86
DONNIE S. TANKERSLEY
R.M.C.

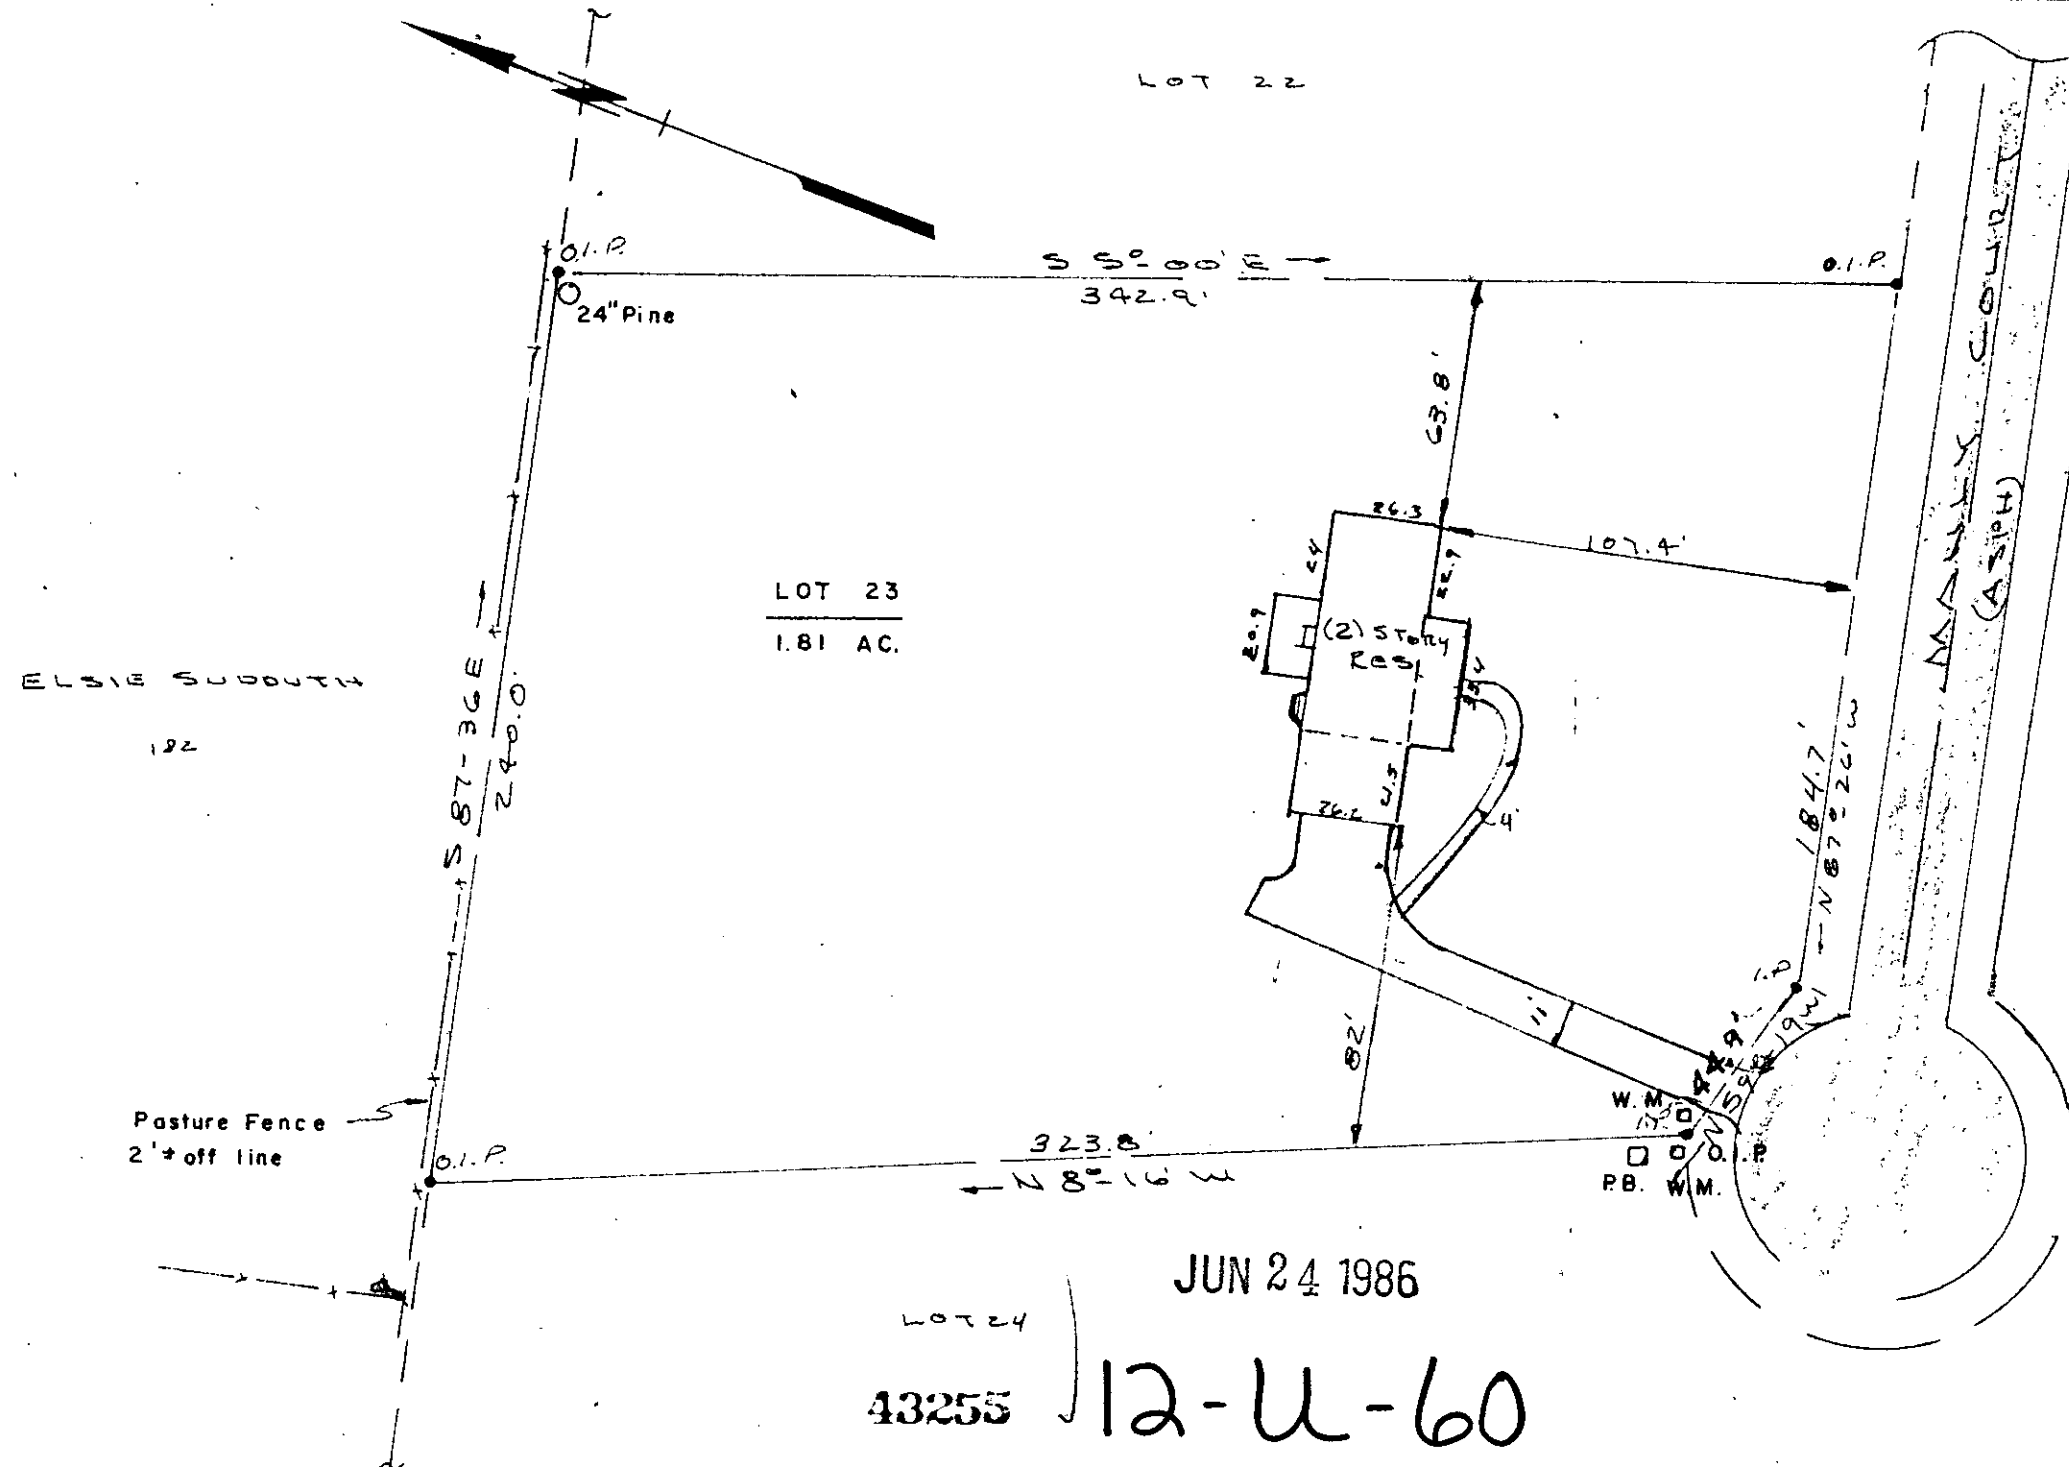

5' DRAINAGE BASEMENT EA. SIDE
OF REAR & SIDE LOT LINES.
U.G. POWER & TEL., WATER IN STREET,
& SEPTIC TANK.

"CAMERON WOODS"

GREENVILLE COUNTY
ONEAL TOWNSHIP
GREER, S.C.
(OFF FEWS CHAPEL RD.)

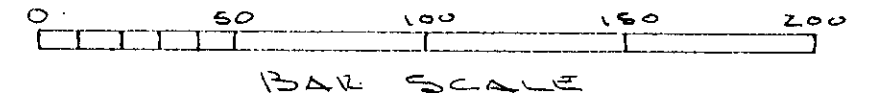

JUN 24 1986

LOT 24
43255 12-U-60

I CERTIFY THE ABOVE LOT HAS BEEN
SURVEYED AND IS AS SHOWN TO THE
BEST OF MY KNOWLEDGE. THERE ARE
NO ENCROACHMENTS & LOT IS NOT LOCATED
IN A HAZARDOUS SLOPE PLAIN AREA

Kenul M. Gould
 S.C. REG. NO. 2035
 KENUL M. GOULD
 S.C. REG. NO. 2035
 TAYLOR

Block Book No. 635.5-1-23
Plat Book 9R Page 37
Deed Vol. 1188 Page 97

PROPERTY OF JACK H. JR & KATHY H. OSHIELDS		
SCALE 1" = 50'	APPROVED BY	DRAWN BY K.T.C.
DATE 6-18-86		
K.T. GOULD INC. - SURVEYORS - TAYLORS, S.C.		
LOT #23, 1.81 ± AC.		DRAWING NUMBER