



FILED
GREENVILLE CO. S. C.
JUN 24 2 25 PM '86
DUNNIE S. TAKKERSLEY
R.M.C.

Magnetic North ref DEED 1059-804 &
TAX MAP 500-92-1-1.3

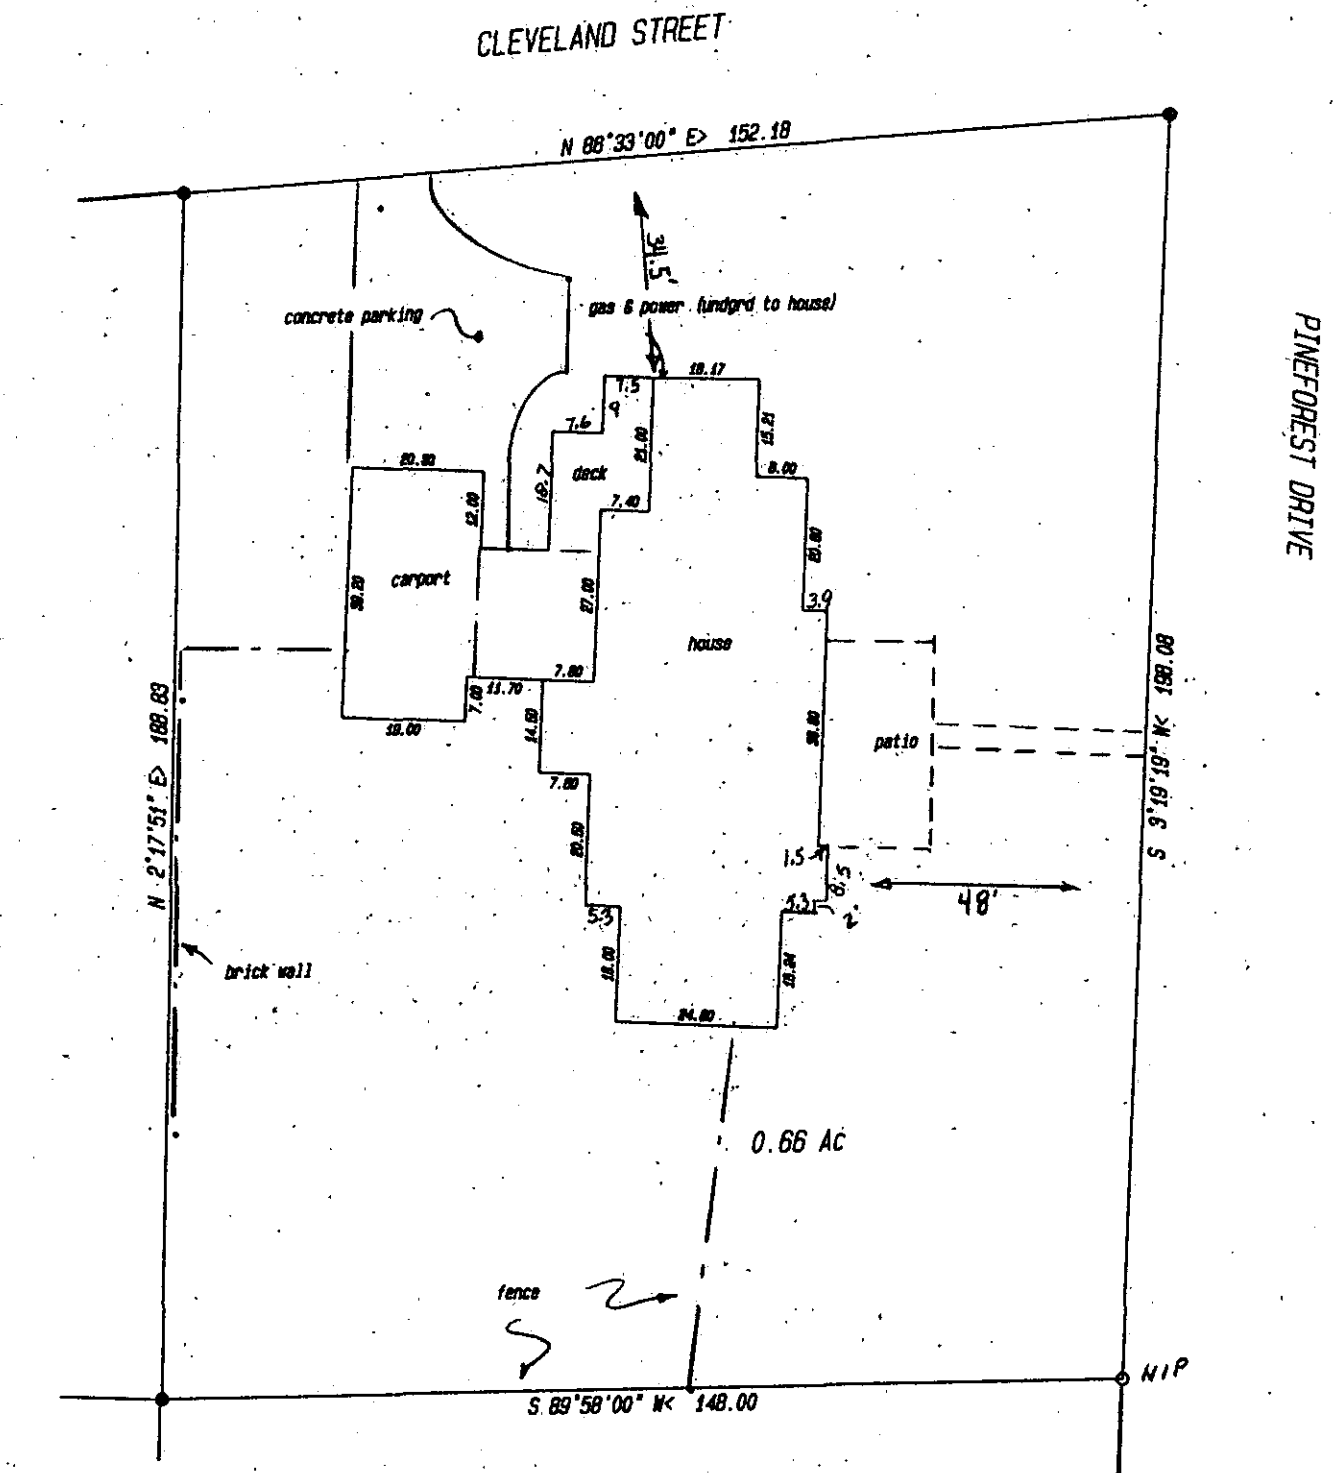


● = Existing Iron Pin, NIP = New Iron Pin, RR = Railroad Spike, N/C = Nail & Cap, MH = Manhole

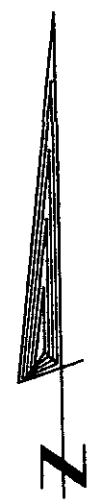

I certify that this plat was prepared from a field survey made under my supervision and the precision is 1:7500+. This property does not encroach on adjoining property and adjoining property does not encroach on this property (except as shown) and this house is not located in a designated flood hazard area

John R Long SC RLS 6270

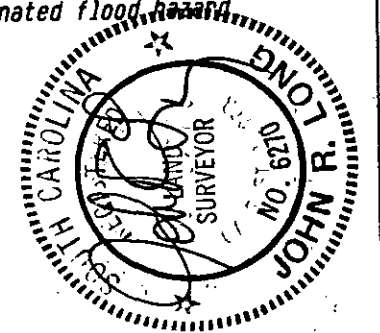

43363

12-4-63 JUN 24 1986

--- PORTER B. & ANN R. ROSE ---

GREENVILLE COUNTY, SOUTH CAROLINA


CITY OF GREENVILLE June 09, 1986

SCALE 1" = 30' JOB 627-3252

John R Long & Associates
803-654-5033

Clemson, South Carolina 762

SCALE 1" = 30'

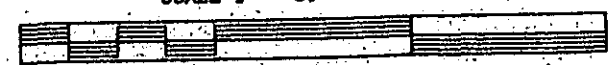

5.000