

FILED
GREENVILLE CO. S.C.
JUL 1 4 42 PM '85
GURRIE S. TANKERSLEY
R.M.C.

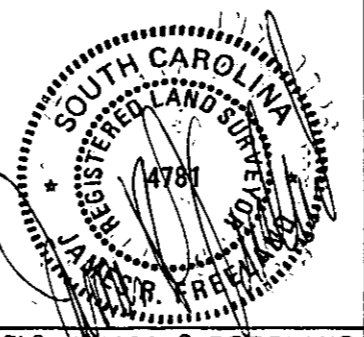
12-U-73

272



THIS IS TO CERTIFY THAT THE PROPERTY SHOWN ON THIS PLAT WAS SURVEYED UNDER MY DIRECT SUPERVISION. PROPERTY LINES AND IMPROVEMENTS SHOWN ARE LOCATED CORRECTLY AND THAT NO VISIBLE ENCROACHMENTS EXIST UNLESS OTHERWISE SHOWN. THIS HOUSE IS NOT LOCATED IN A DESIGNATED FLOOD HAZARD AREA.

THE PRINT MACHINE, INC. N61205

 RLS: JAMES R. FREELAND NO: 4781	STATE OF SOUTH CAROLINA GREENVILLE COUNTY	FREELAND & ASSOCIATES Engineers • Land Surveyors 318 WEST STONE AVENUE. GREENVILLE, S.C. (803) 271-4924
	PROPERTY OF <u>JOSEPH P. DONOHUE</u> ✓ <u>SANDRA S. MORGAN</u> ✓	PLAT BOOK DEED BOOK TAX MAP 189.1-1-9 PARTY CHIEF G.P. DRAWN I.R. DATE JUNE - 12 - 85 DWG. NO. 10188#1

500