
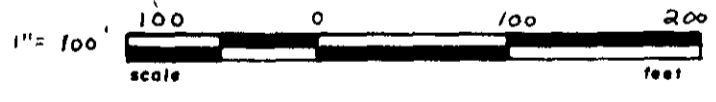
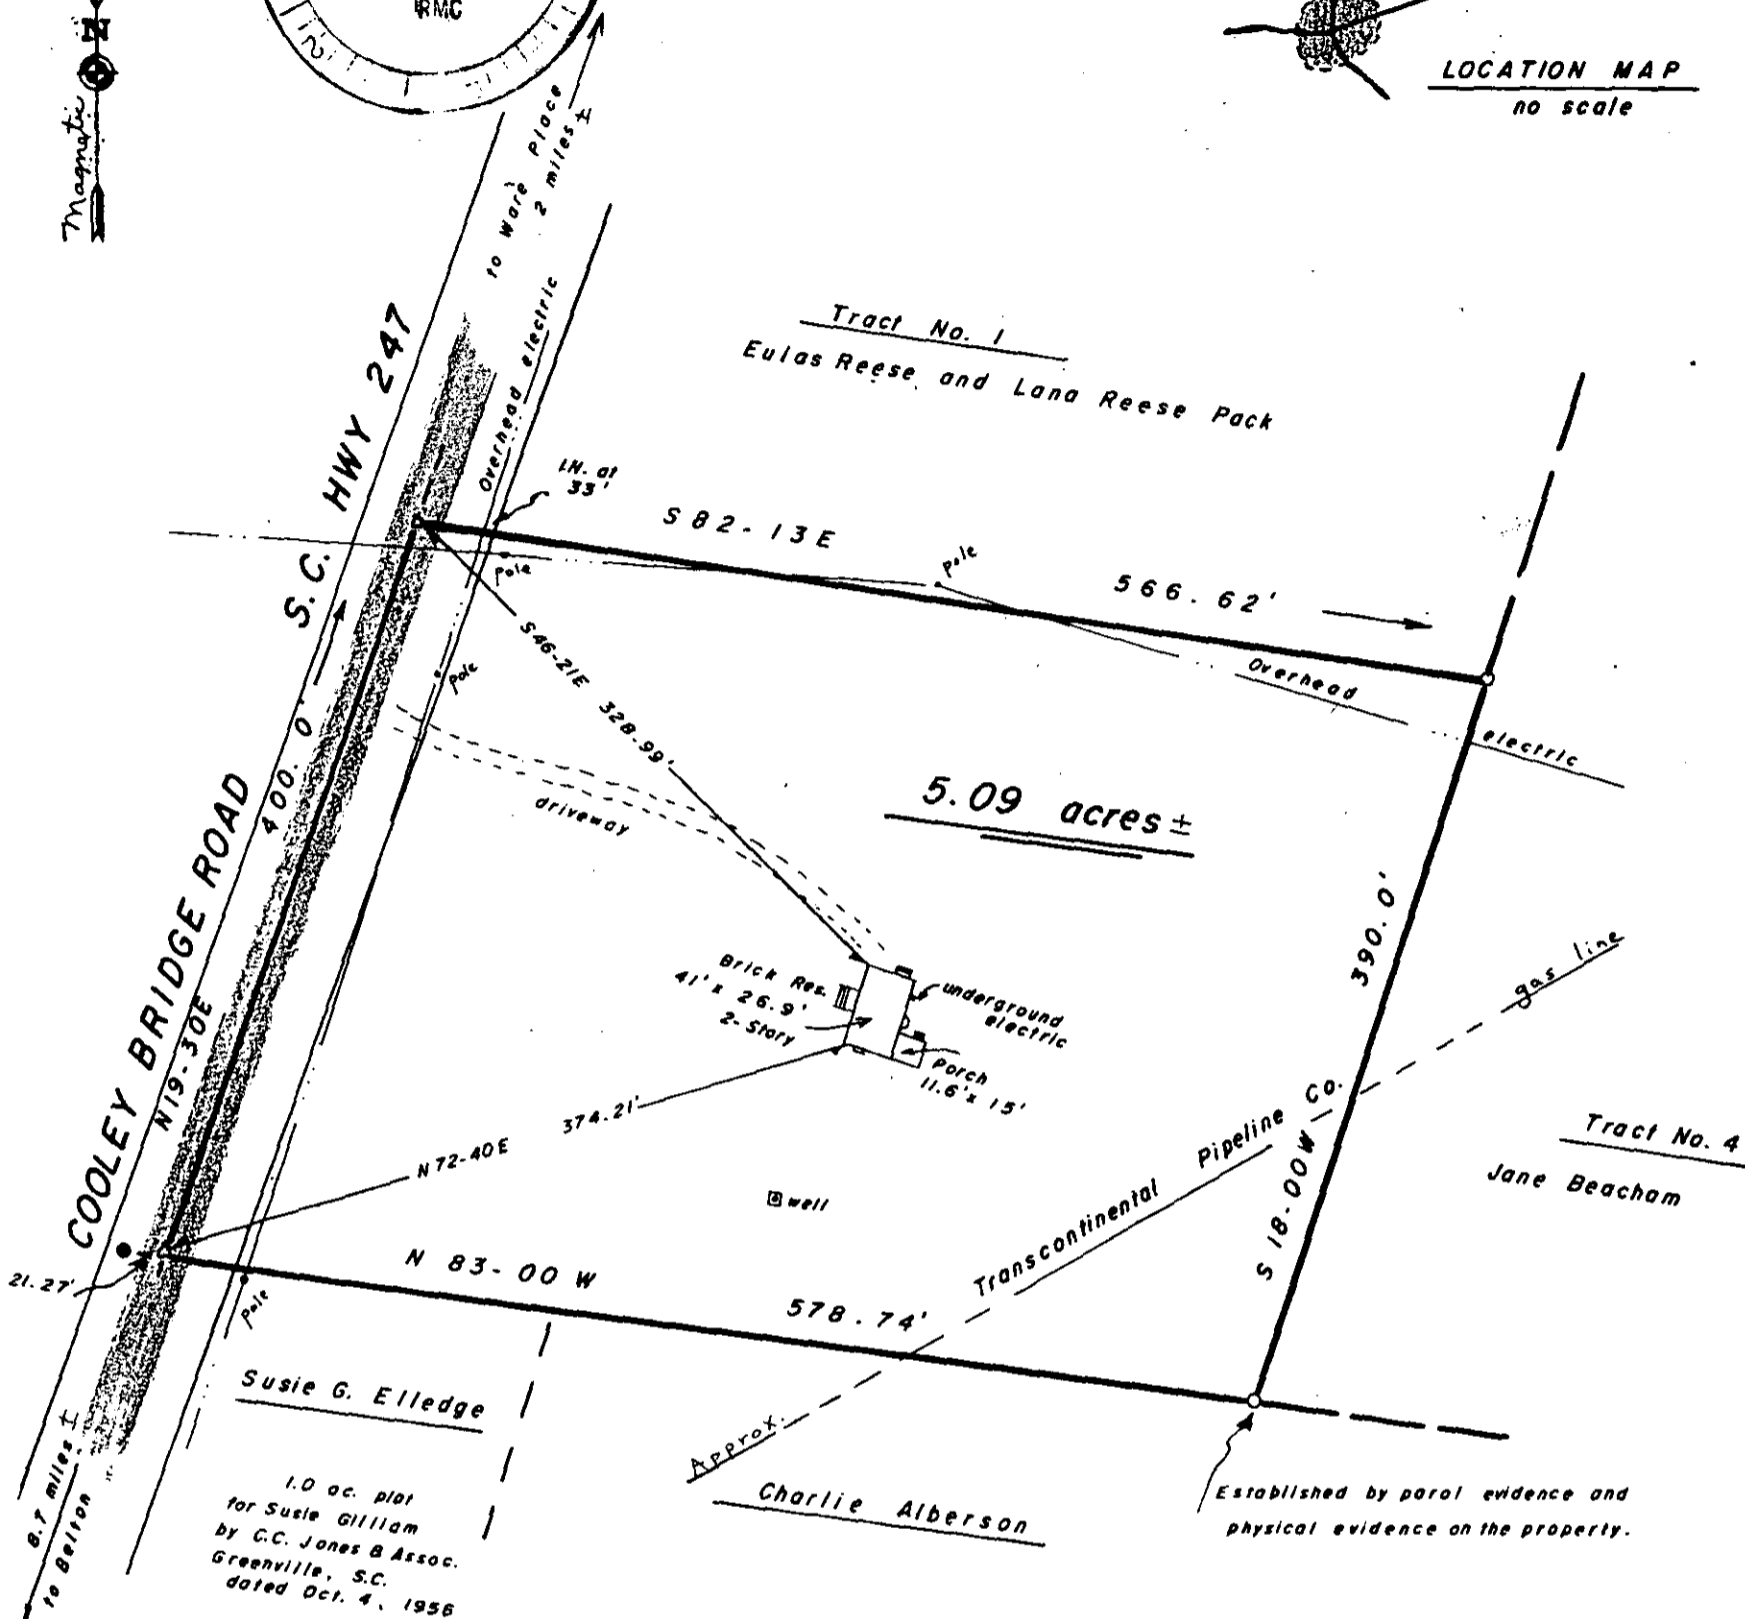
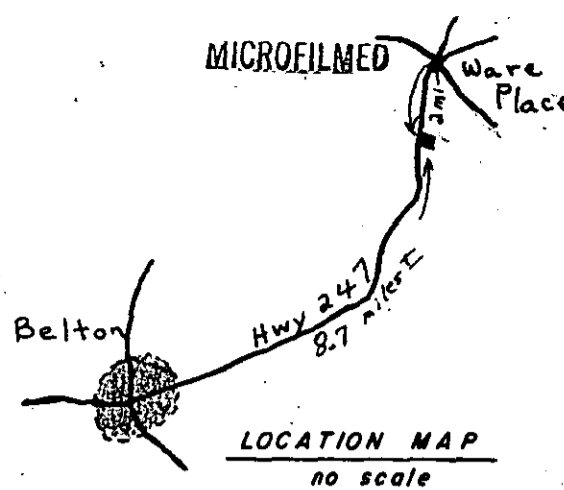


MICROFILMED

Ware Place

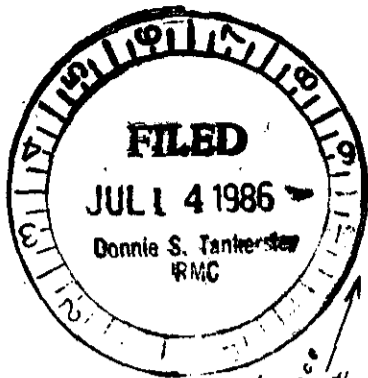

- 1.0 - Iron pin, old
- 1.N. - Iron pin, new
- ▲ Nail in cap, old
- △ Nail in cap, new
- E.C. - 1/5,000 or greater
- Ared - DMD Method

STATE OF SOUTH CAROLINA
COUNTY OF GREENVILLE

LOAN SURVEY

At the request of **LANA REESE PACK**
June 30 - July 2, 1986

1850

12-4-95

Remarks: This being a portion of a 5.32 acre tract, Tract 2 as shown on a plat by **JUL 14 1986**
G. A. Ellis dated June 10, 1946 for Berry Owens.


This is to certify that the measurements as shown above are correct and that there are no encroachments or projections other than shown.

This property is not located in a special flood hazard area.

This property is subject to any and all rights of way and/or easements of record.



ANDERSON SURVEYING ASSOCIATES, INC.
P. O. Box 784 - Phone 226-7813
106 E. Morris
ANDERSON, S. C. 29622

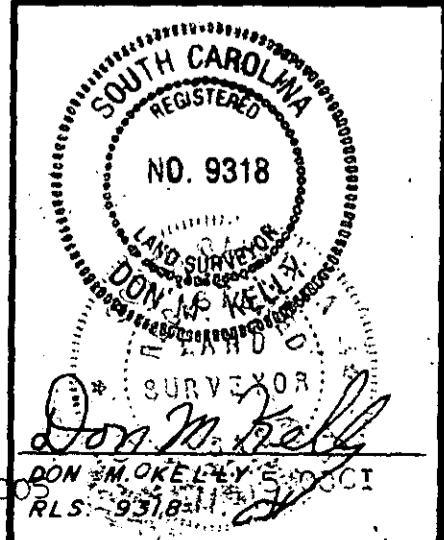

GOTO -- 3 JUL 14 86
TM 0605.02-01-007.00