MICROFILMED

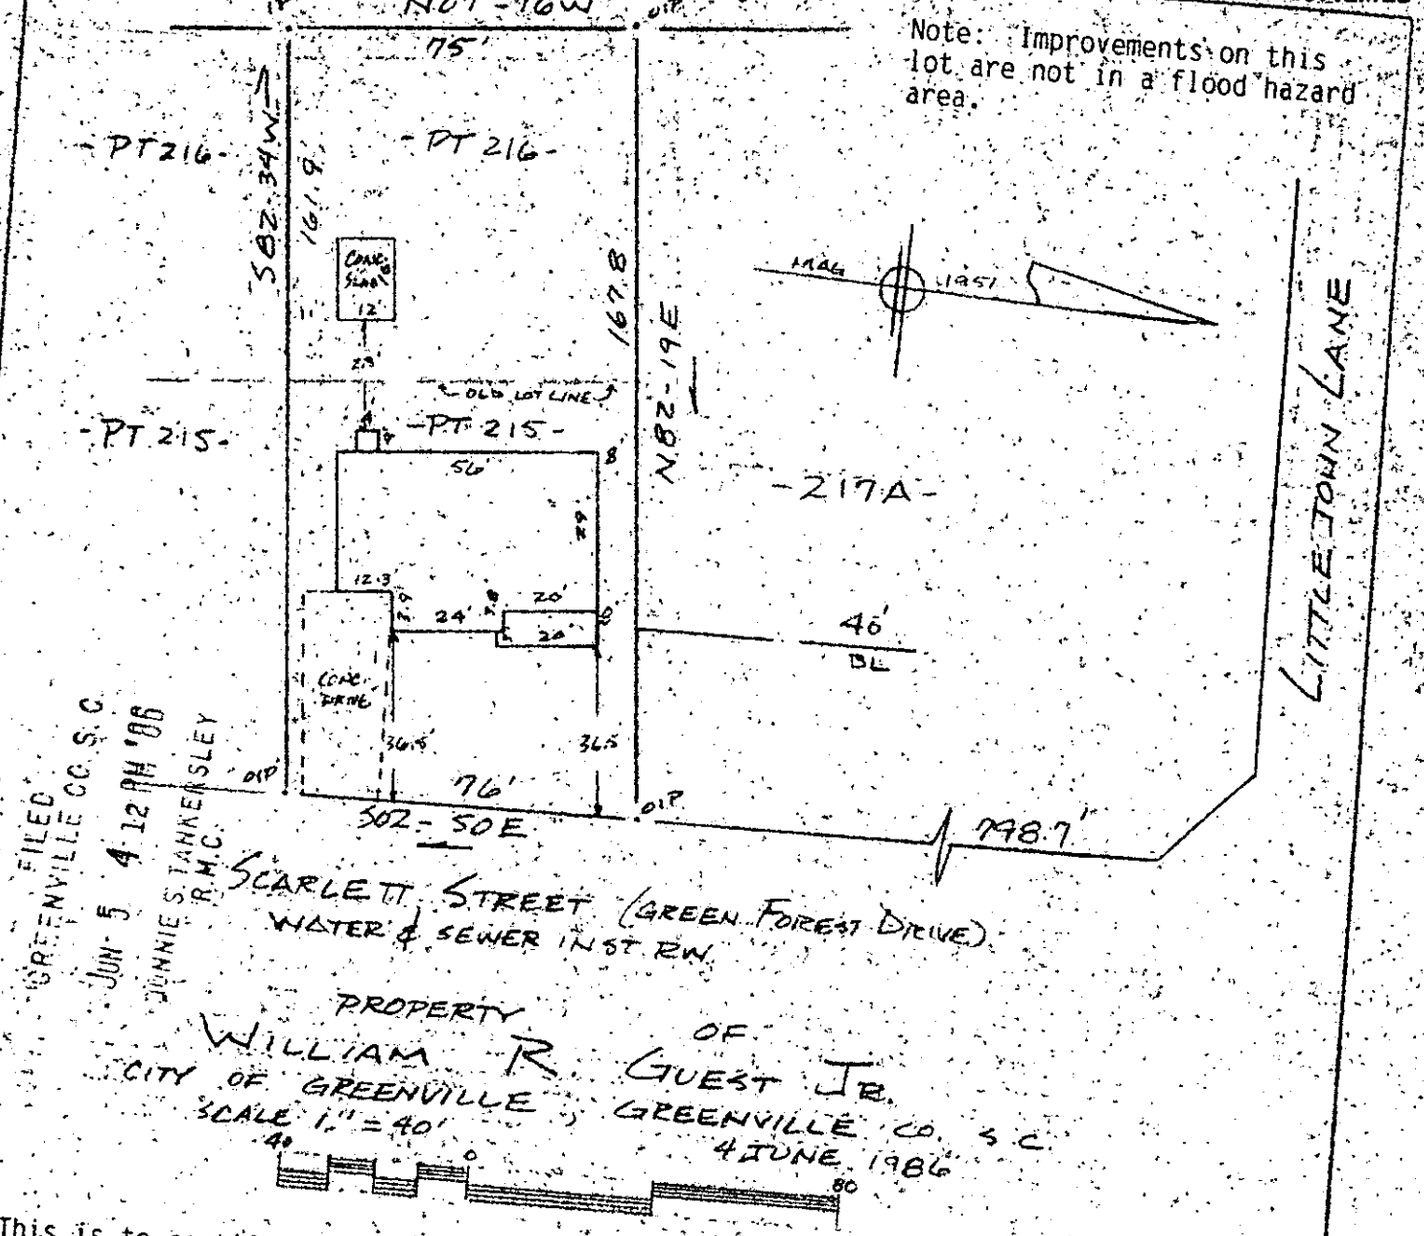

FILED
GREENVILLE CO. S. C.
JUN 5 4 12 PM '86
JOHNNIE STAHKENSLEY
R.M.C.

This is to certify that on the 4th day of June, 1986, I surveyed the property shown on this plat, being known as part of lot 215 and part of lot 216 on plat of SHERWOOD FOREST and recorded in the RMC Office Greenville County, S.C., in Plat Book " GG " at Page 71; and that the property lines, walls and buildings are as shown hereon, and that the walls and buildings encroach or project on adjacent street or property, and that no adjacent walls or buildings encroach or project on said premises, no power lines cross this property and no visible encroachments except as shown hereon.

40759

R. B. Bruce

R. B. Bruce, RLS #1952

12-V-24

JUN 5 1986

CAROLINA SURVEYING COMPANY
112 Manly St.
Greenville, S.C.

Recordable Plat

RECD JUN05 86 030 3.00CD

307/24

267-1-84