

Note: Improvements on this lot are not in a flood hazard area. MICROFILMED




GREENVILLE, S.C.
JUN 9 2:09 PM '86
DONNIE TANKERSLEY
R.M.C.

COBBLESTONE ROAD
WATER IN ST. RW.

PROPERTY OF
KENNETH A. WALKER & SABRINA E. WALKER
NEAR GREENVILLE, S.C.

Note: all lots to have a 5' drainage & utility easement along side lot lines & a 10' easement along rear lot lines unless otherwise shown.

SCALE 1" = 40'
4 JUNE 1986

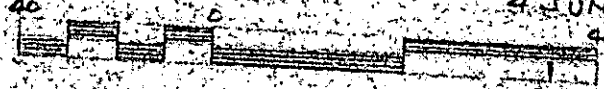

This is to certify that on the 4th day of June, 1986, I surveyed the property shown on this plat, being known as lot 68 on plat of SECTION I BROOKFIELD WEST and recorded in the RMC Office Greenville County, S.C., in Plat Book "7-C" at Page 19, and that the property lines, walls and buildings are as shown hereon, and that the walls and buildings located on said lot do not encroach or project on adjacent street or property, and that no adjacent walls or buildings encroach or project on said premises, no power lines cross this property and no visible encroachments except as shown hereon.

JUN 9 1986

12-V-37

41135

R. B. Bruce
R. B. Bruce, RLS #1952
R. B. Bruce

CAROLINA SURVEYING COMPANY
112 Manly St.
Greenville, S.C.

Recordable Plat

308/6A

540-19-1-33 300 8

1801

220571