


NOTE: 5' DRAINAGE & UTILITY EASEMENT ALONG EACH SIDE OF ALL SIDE & REAR LOT LINES.

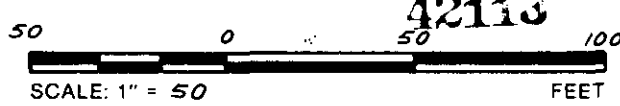

THIS IS TO CERTIFY THAT THE PROPERTY SHOWN ON THIS PLAT WAS SURVEYED UNDER MY DIRECT SUPERVISION. PROPERTY LINES AND IMPROVEMENTS SHOWN ARE LOCATED CORRECTLY AND THAT NO VISIBLE ENCROACHMENTS EXIST UNLESS OTHERWISE SHOWN. THIS PROPERTY IS NOT LOCATED IN A DESIGNATED FLOOD HAZARD AREA.

**SOUTH CAROLINA REGISTERED LAND SURVEYORS**  
 4781  
**JAMES R. FREELAND**  
 RLS. JAMES R. FREELAND  
 NO. 4781

**STATE OF SOUTH CAROLINA  
 GREENVILLE COUNTY**

OAK MEADOWS  
LOT 32  
PROPERTY OF  
CHARLES B. BURNETTE, JR.  
SANDRA S. BURNETTE

**FREELAND & ASSOCIATES**  
 Engineers • Land Surveyors  
 318 WEST STONE AVENUE.  
 GREENVILLE, S.C.  
 (803) 271-4924

PLAT BOOK	9W-57
DEED BOOK	
TAX MAP	539-7-1-32
PARTY CHIEF	MLC
DRAWN	B.R.
DATE	JUNE 12, 1986
DWG. NO.	15484