



43508

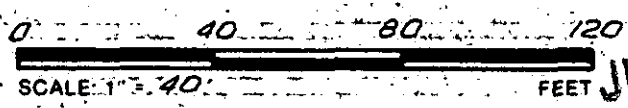

JUN 25 1986

12-W-57

THIS IS TO CERTIFY THAT THE PROPERTY SHOWN ON THIS PLAT WAS SURVEYED UNDER MY DIRECT SUPERVISION. PROPERTY LINES AND IMPROVEMENTS SHOWN ARE LOCATED CORRECTLY AND THAT NO VISIBLE ENCROACHMENTS EXIST UNLESS OTHERWISE SHOWN. THIS PROPERTY IS NOT LOCATED IN A DESIGNATED FLOOD HAZARD AREA.

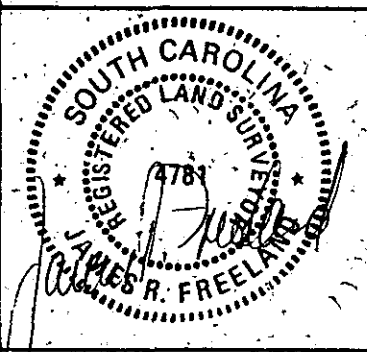

STATE OF SOUTH CAROLINA  
GREENVILLE COUNTY

WESTWOOD  
SEC. 1, LOT 81  
PROPERTY OF  
JAN WARREN WILLIAMS

FREELAND-CLINKSCALES  
& ASSOCIATES, INC.  
Engineers • Land Surveyors  
323 WEST STONE AVENUE  
GREENVILLE, S.C.  
(803) 271-4924

PLAT BOOK	4 F-21
DEED BOOK	
TAX MAP	
PARTY CHIEF	J.E.C.
DRAWN	I.R.
DATE	MAY - 19 - 86
DWG. NO.	15251

PLS: JAMES R. FREELAND  
NO: 4781