MICROFILMED

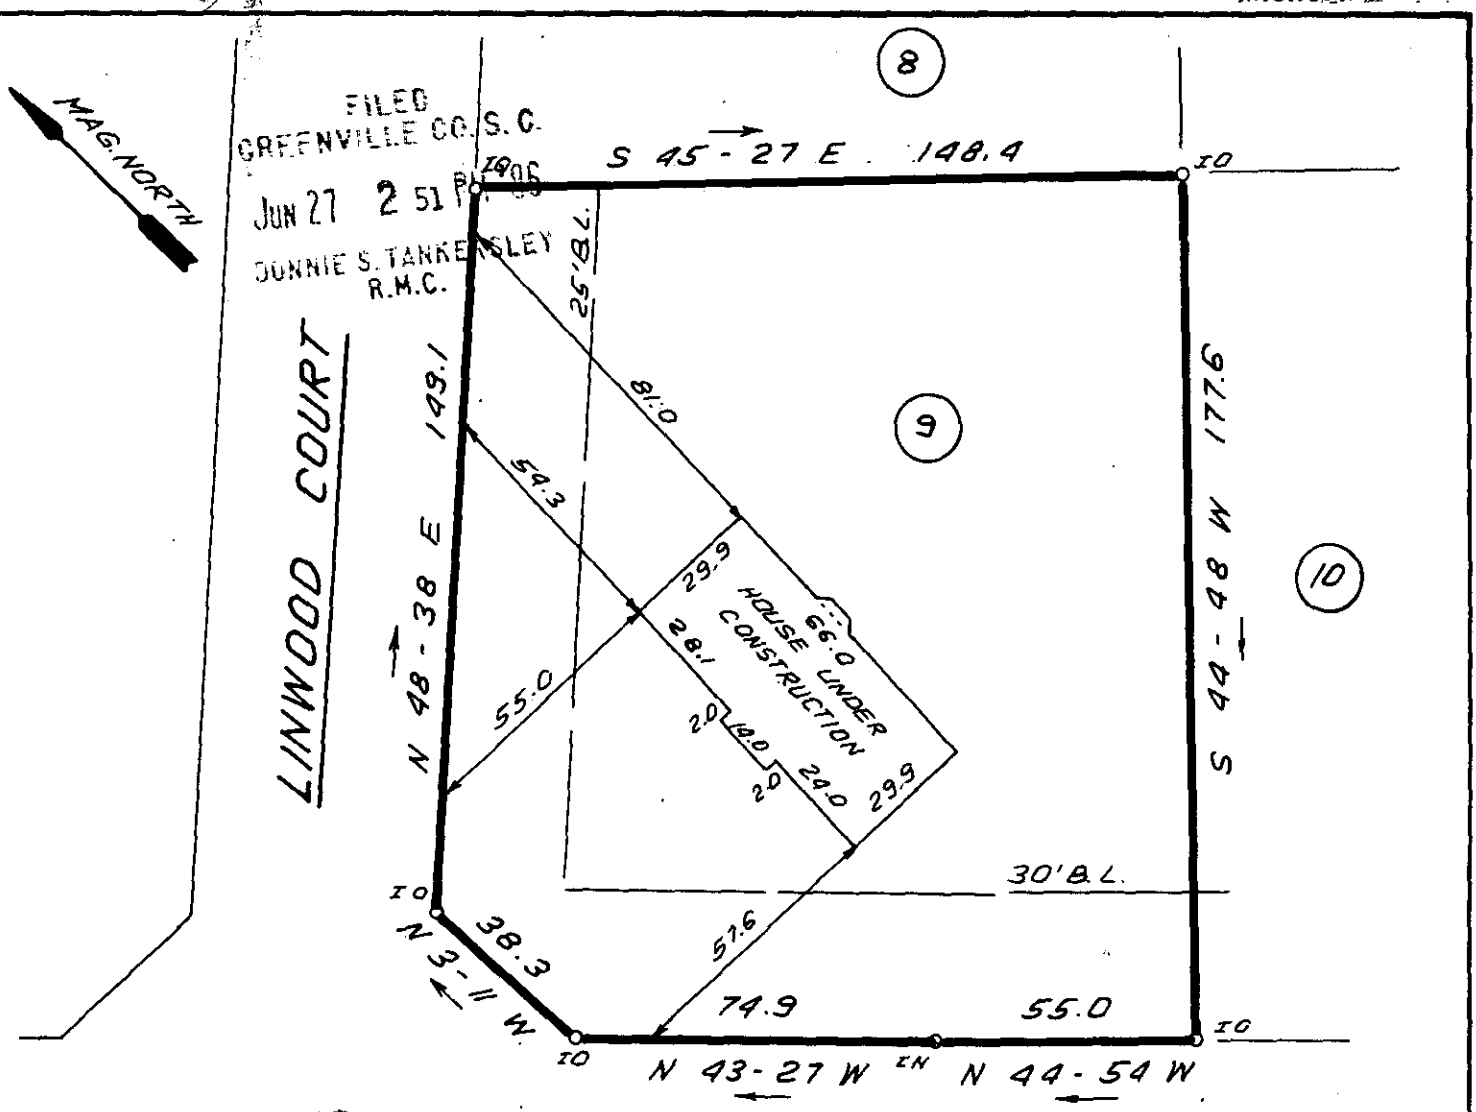

JUN 27 1986

12-W-72

PLANTATION DRIVE

43844

0 40 80 120

SCALE: 1" = 40' FEET

NOTE: 5' DRAINAGE & UTILITY EASEMENT ALONG EACH SIDE OF ALL SIDE & REAR LOT LINES, UNLESS OTHERWISE SHOWN.

THIS IS TO CERTIFY THAT THE PROPERTY SHOWN ON THIS PLAT WAS SURVEYED UNDER MY DIRECT SUPERVISION. PROPERTY LINES AND IMPROVEMENTS SHOWN ARE LOCATED CORRECTLY AND THAT NO VISIBLE ENCROACHMENTS EXIST UNLESS OTHERWISE SHOWN. THIS *PROPERTY* IS *NOT* LOCATED IN A DESIGNATED FLOOD HAZARD AREA

SOUTH CAROLINA REGISTERED LAND SURVEYOR 10034 MACK L. CHAPMAN, JR.

RLS MACK L. CHAPMAN, JR.

NO. 10034

STATE OF SOUTH CAROLINA
GREENVILLE COUNTY

HOLLY TREE PLANTATION
PHASE 3; SEC. 3; LOT 9
PROPERTY OF
FRANKLIN ENTERPRISES, INC.

OCTO -- 3 JN27 86 14

FREELAND-CLINKSCALES & ASSOCIATES, INC.
Engineers • Land Surveyors
323 WEST STONE AVENUE
GREENVILLE, S.C.
(803) 271-4924

PLAT BOOK	11 - I - 61
DEED BOOK	
TAX MAP	548.5-1-9
PARTY CHIEF	J.P.S.
DRAWN	I.R.
DATE	JUNE - 24 - 86
DWG. NO	15598

THE PRINT MACHINE, INC. N73428