


7

FILED  
GREENVILLE CO. S. C.  
JUL 2 10 13 AM '86  
DUNNIE S. TANKERSLEY  
R.M.C.

PROPERTY OF  
**ROBERT H. KLINE**  
&  
**DOROTHY L. KLINE**

GREENVILLE COUNTY, S.C.  
JUNE 30, 1986

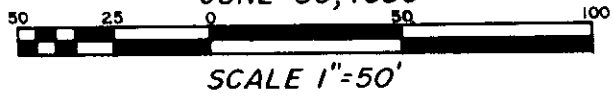

This is to certify that on June 30, 1986, I surveyed the property shown on this plat known as Lot No. 72 of Devenger Place, Section No. 7, as recorded in the RMC Office for Greenville County in Plat Book 5-P at Page 97, and that the property lines, walls and buildings are as shown hereon, and that the building located on said lot does not project nor encroach on adjacent streets or property, and that no adjacent walls or buildings project nor encroach on said lot, and that no utility lines cross this lot except as may be shown hereon. The degree of accuracy is 1:10,000.

NOTE: This property is not located within a flood hazard area.

Surveyed by: *Richard B. Wooten, Jr.*  
Greenville, South Carolina

5' drainage and utility easement along all rear and side lot lines.

SOUTH CAROLINA  
REGISTERED SURVEYOR  
*Richard B. Wooten, Jr.*  
S. C. REG. SURV. NO. 4678  
COLUMBIA

12-K-20

RECORDABLE PLAT