

OLIVE STREET
WATER & SEWER IN ST R/W


MICROFILMED

FILED
GREENVILLE CO S.C.
JUL 10 11 53 AM 1986

FILED
ST5-12E-1
91.0

BONNIE STANKERS
R.M.C.

MAG
11955

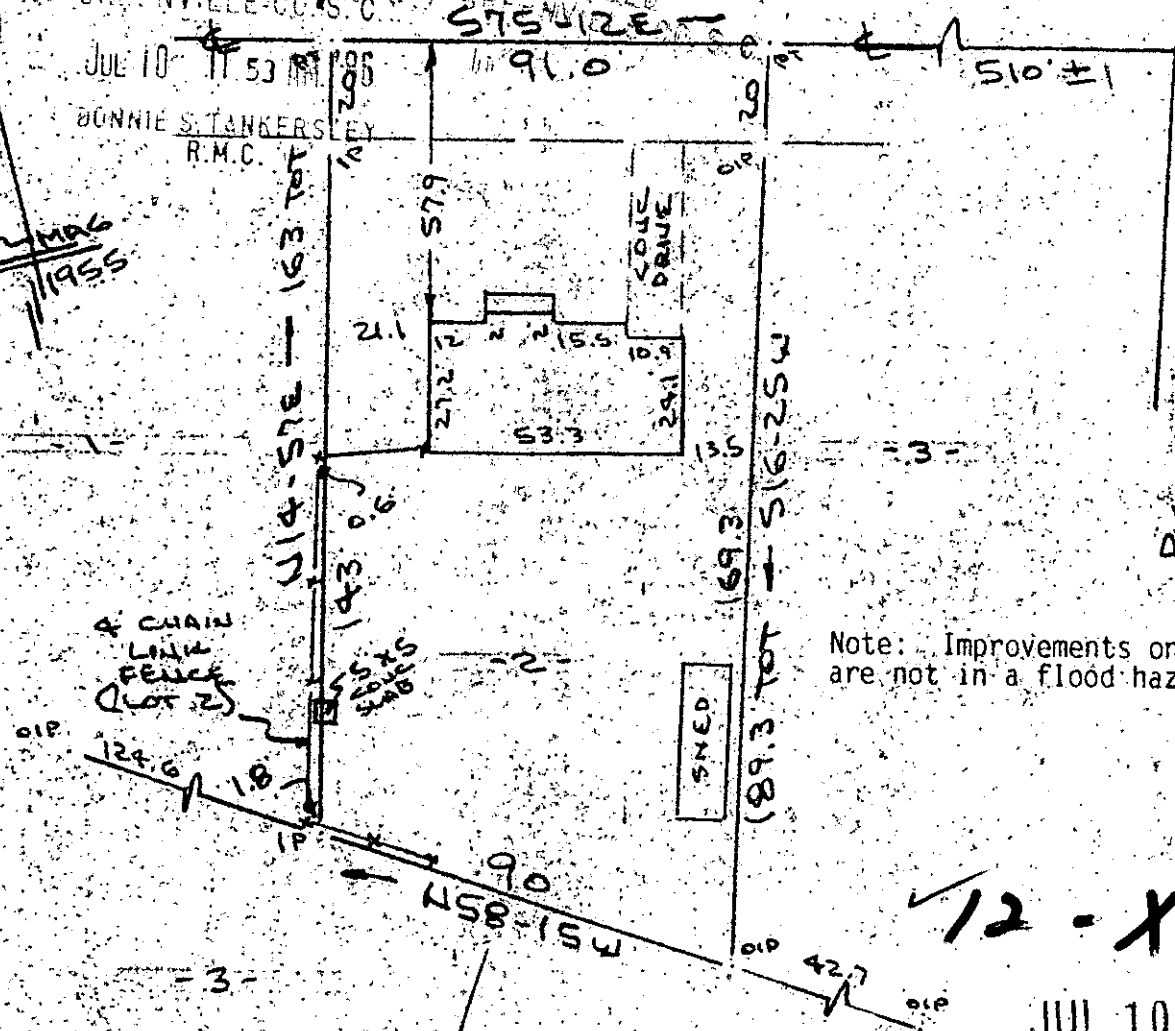

Note: Improvements on this lot are not in a flood hazard area.

12-X-71


JUL 10 1986

DELUISTA SUB-DIV

PROPERTY OF
MARION G. TYNER & ELAINE W. TYNER

NEAR GREENVILLE, GREENVILLE CO, S.C.

SCALE: 1"=40' 7 JULY 1986

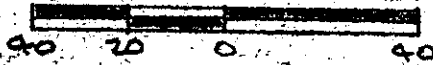

This is to certify that on the 7th day of July, 1986, I surveyed the property shown on this plat, being known as lot 2 on plat of J. O. JONES and recorded in the RMC Office Greenville County, S.C., in Plat Book " JJ " at Page 185 and also being known as PROPERTY OF MARION G. TYNER & ELAINE W. TYNER and recorded in Plat Book " " at Page , and that the property lines, walls and buildings are as shown hereon, and that the walls and buildings located on said lot do not encroach or project on adjacent street or property, and that no adjacent walls or buildings encroach or project on said premises, no power lines cross this property and no visible encroachments except as shown hereon.

1391

R. B. Bruce

R. B. Bruce, RLS #1952

3.00CI

CAROLINA SURVEYING COMPANY
112 Manly St. Greenville, S.C.

Recordable Plat