


Note: Improvements on this lot are not in a flood hazard area.

MICROFILMED

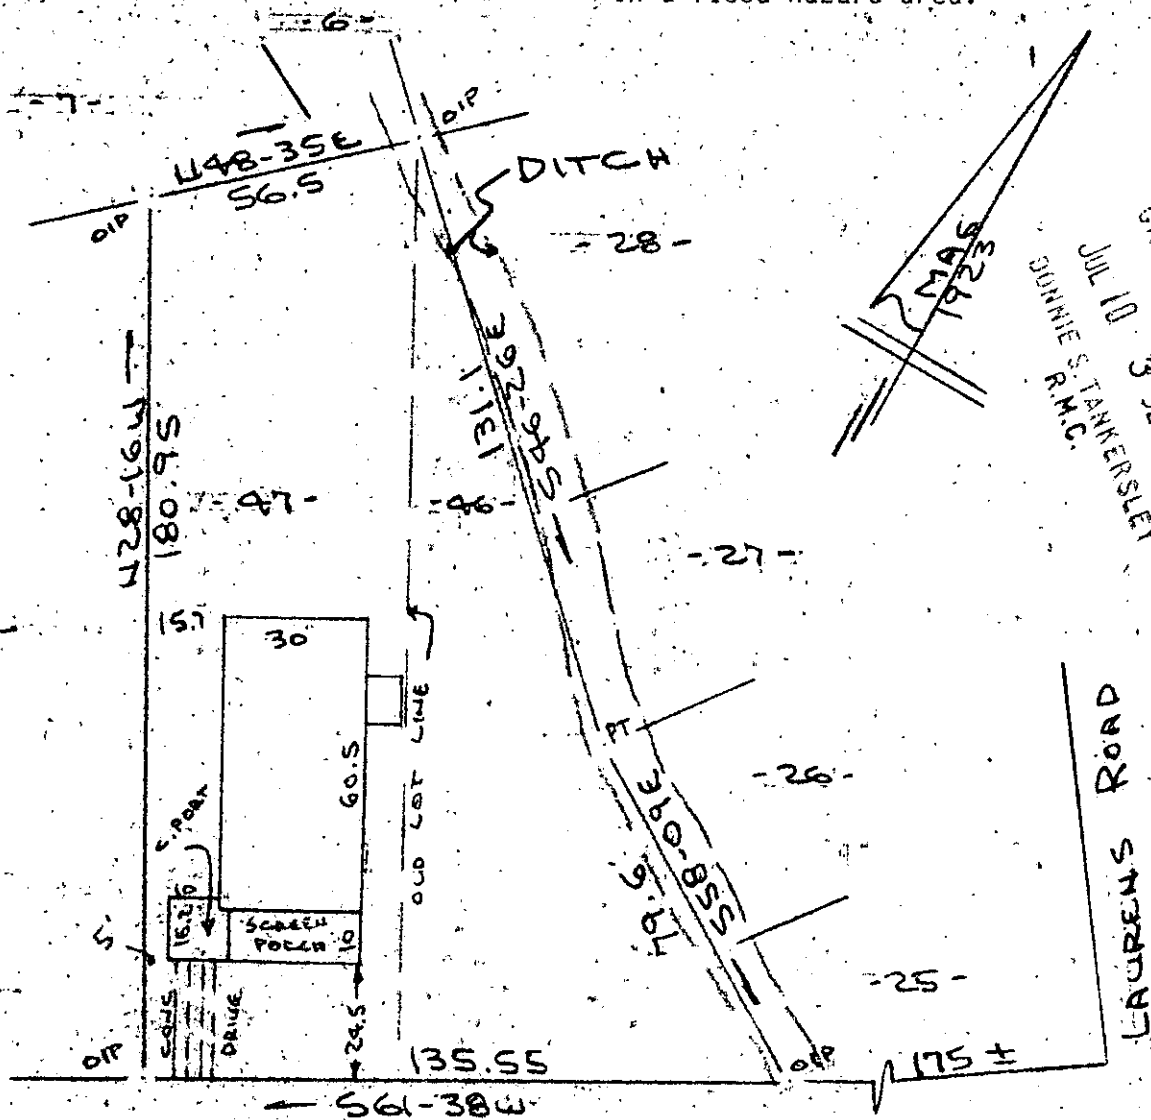

FILED
 GREENVILLE CO. S.C.
 JUL 10 3 32 PM '86
 BONNIE S. TANKERSLEY
 R.M.C.

BRUNSON STREET (GRACE STREET)
 WATER & SEWER IN ST. R/W


PROPERTY OF
 WILLIAM HENRY OLIVER & SUSAN M. OLIVER

JUL 10 1986

CITY OF GREENVILLE, S.C.

SCALE: 1" = 40' 7 JULY 1986

12-X-73 1476

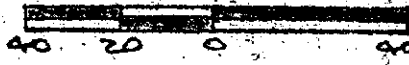

This is to certify that on the 7th day of July, 1986, I surveyed the property shown on this plat, being known as lots 46 & 47 on plat of PROPERTY OF E. G. GLENN and recorded in the RMC Office Greenville County, S.C., in Plat Book "F" at Page 148 and also being known as PROPERTY OF WILLIAM HENRY OLIVER & SUSAN M. OLIVER and recorded in Plat Book " " at Page ; and that the property lines, walls and buildings are as shown hereon, and that the walls and buildings located on said lot do not encroach or project on adjacent street or property, and that no adjacent walls or buildings encroach or project on said premises, no power lines cross this property and no visible encroachments except as shown hereon.

R. B. Bruce

R. B. Bruce, RLS #1952

CAROLINA SURVEYING COMPANY
 112 Manly St. Greenville, S.C.

Recordable Plat

2 JUL 10 1986 142 3:06GT