


MICROFILMED

LOT 39

LOT 40

FILED  
GREENVILLE CO. S. C.  
JUL 14 4 17 PM '86  
BONNIE S. TANKERSLEY  
R.M.C.

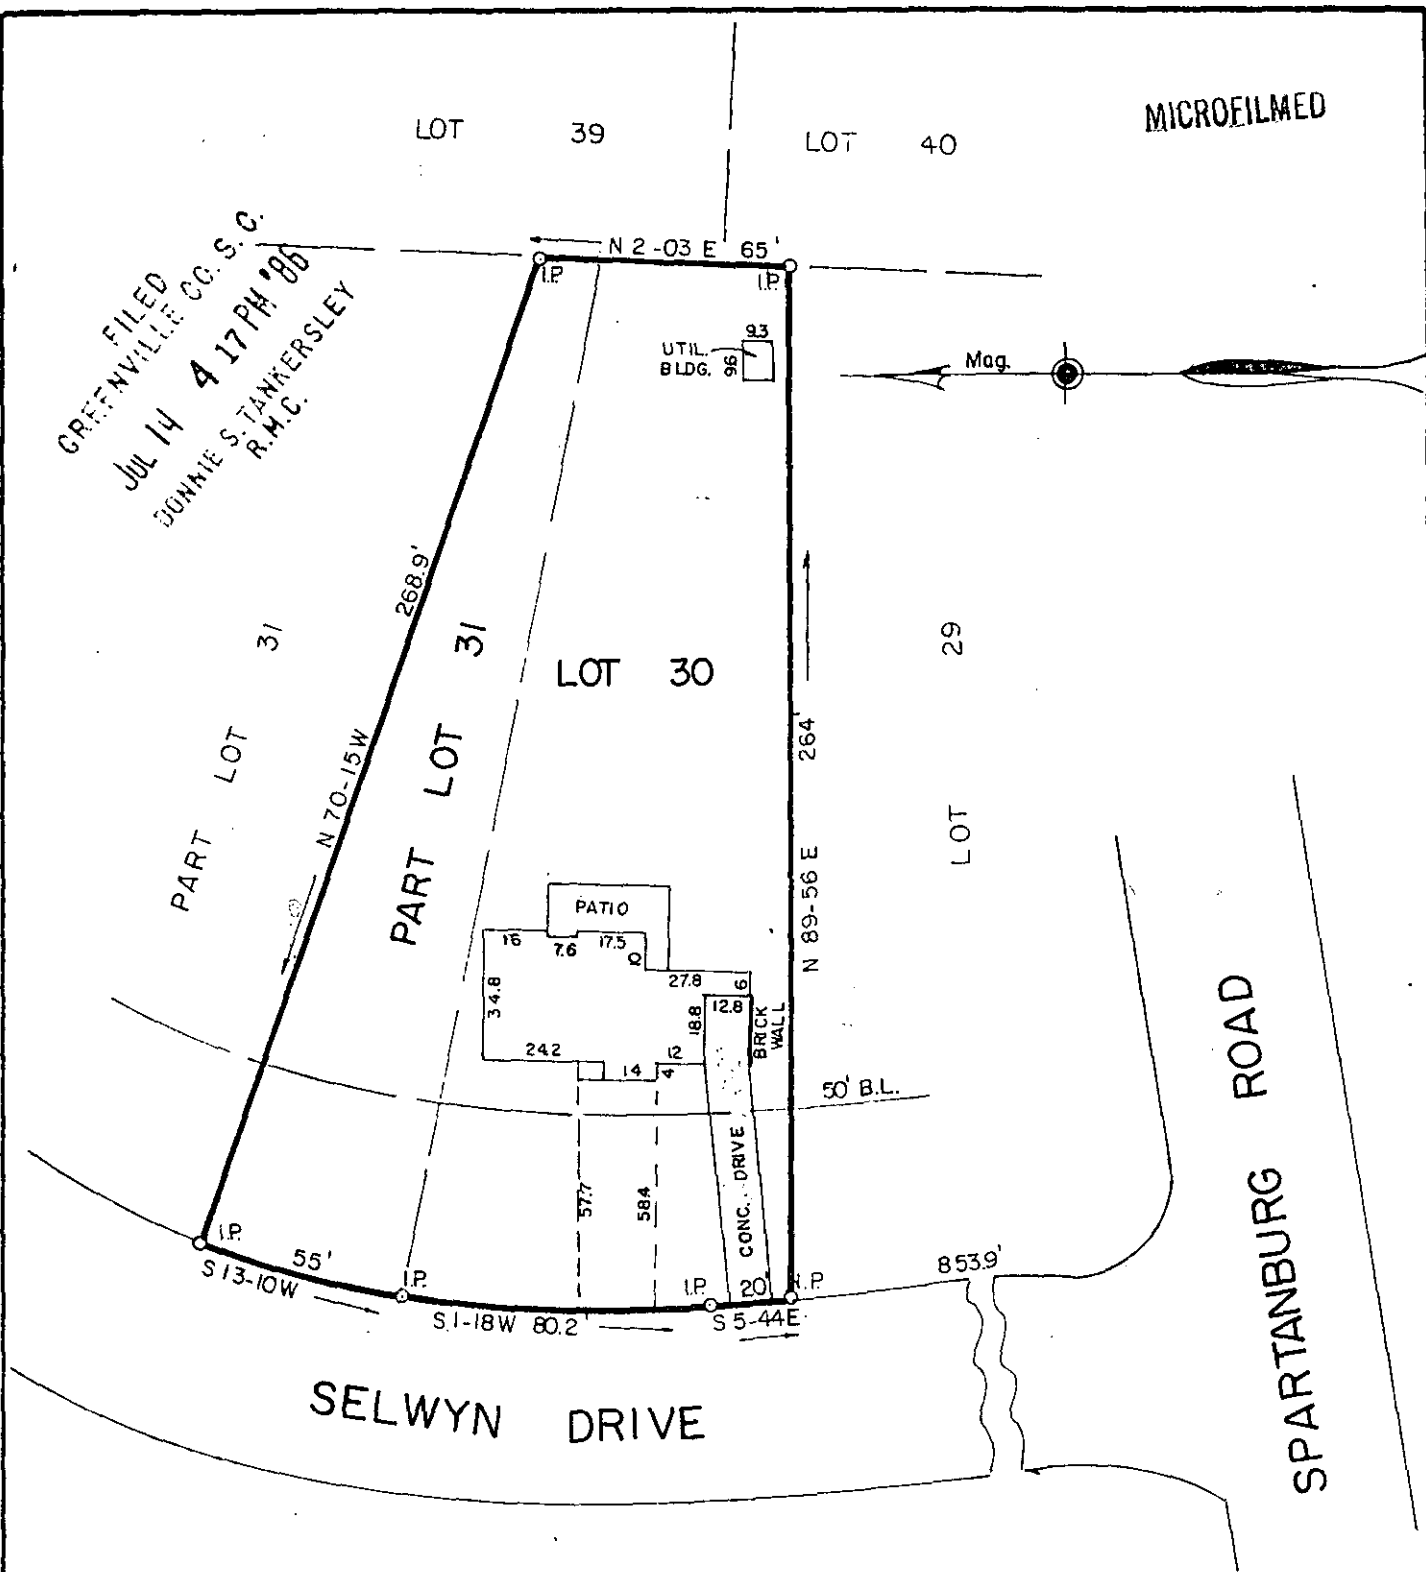

PROPERTY OF  
**WALTER E. GRAINGER, JR.**  
**CATHY C. GRAINGER**

1891

GREENVILLE COUNTY, S. C. JUL 14 1986

Scale 1" = 50' July, 1986

12-X-93

This is to certify that on the 11th day of July, 1986, we surveyed the property shown on this plat being known as Lot 30 and Part Lot 31 on plat of Timberlake, recorded in plat book BB, page 185, Office of R.M.C., Greenville County, S.C.; and that the property lines, walls and buildings are as shown hereon; that the buildings located on said lot do not encroach or project on adjacent streets or property; and that no adjacent buildings or walls encroach or project on said premises; and from information from Greenville County, this structure is not located in a designated flood area.

*[Handwritten signature]*

*[Handwritten signature]*

DALTON & NEVES CO., INC. ENGINEERS