

MICROFILMED

NOTES

1 THERE IS A 5' UTILITY AND DRAINAGE EASEMENT ALONG EACH SIDE OF ALL SIDE PROPERTY LINES, AND A 10' EASEMENT ALONG EACH SIDE OF REAR PROPERTY LINES.


REVISIONS AND RECERTIFICATIONS

NO	BY	DATE	DESCRIPTION	JOB NO. REFERENCE	APP
1					
2					
3					
4					
5					


REFERENCES

BB	DB	PB	III-33
BB	DB 1255-805	PB III-33	LAIL
BB	DB 1253-126	PB 12E-56	VAN SLOOTEN
BB	DB	PB	
BB	DB	PB	

LOCATION MAP

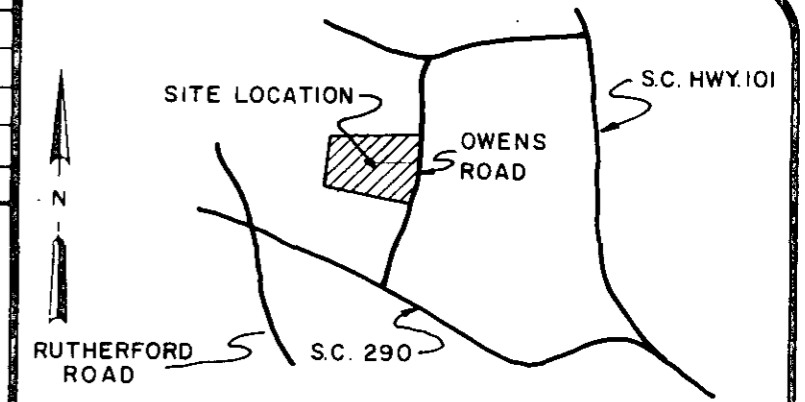

FILED
GREENVILLE CO. S.C.
JUL 23 4 30 PM '86
JONNIE S. TANKERSLEY
R.M.C.

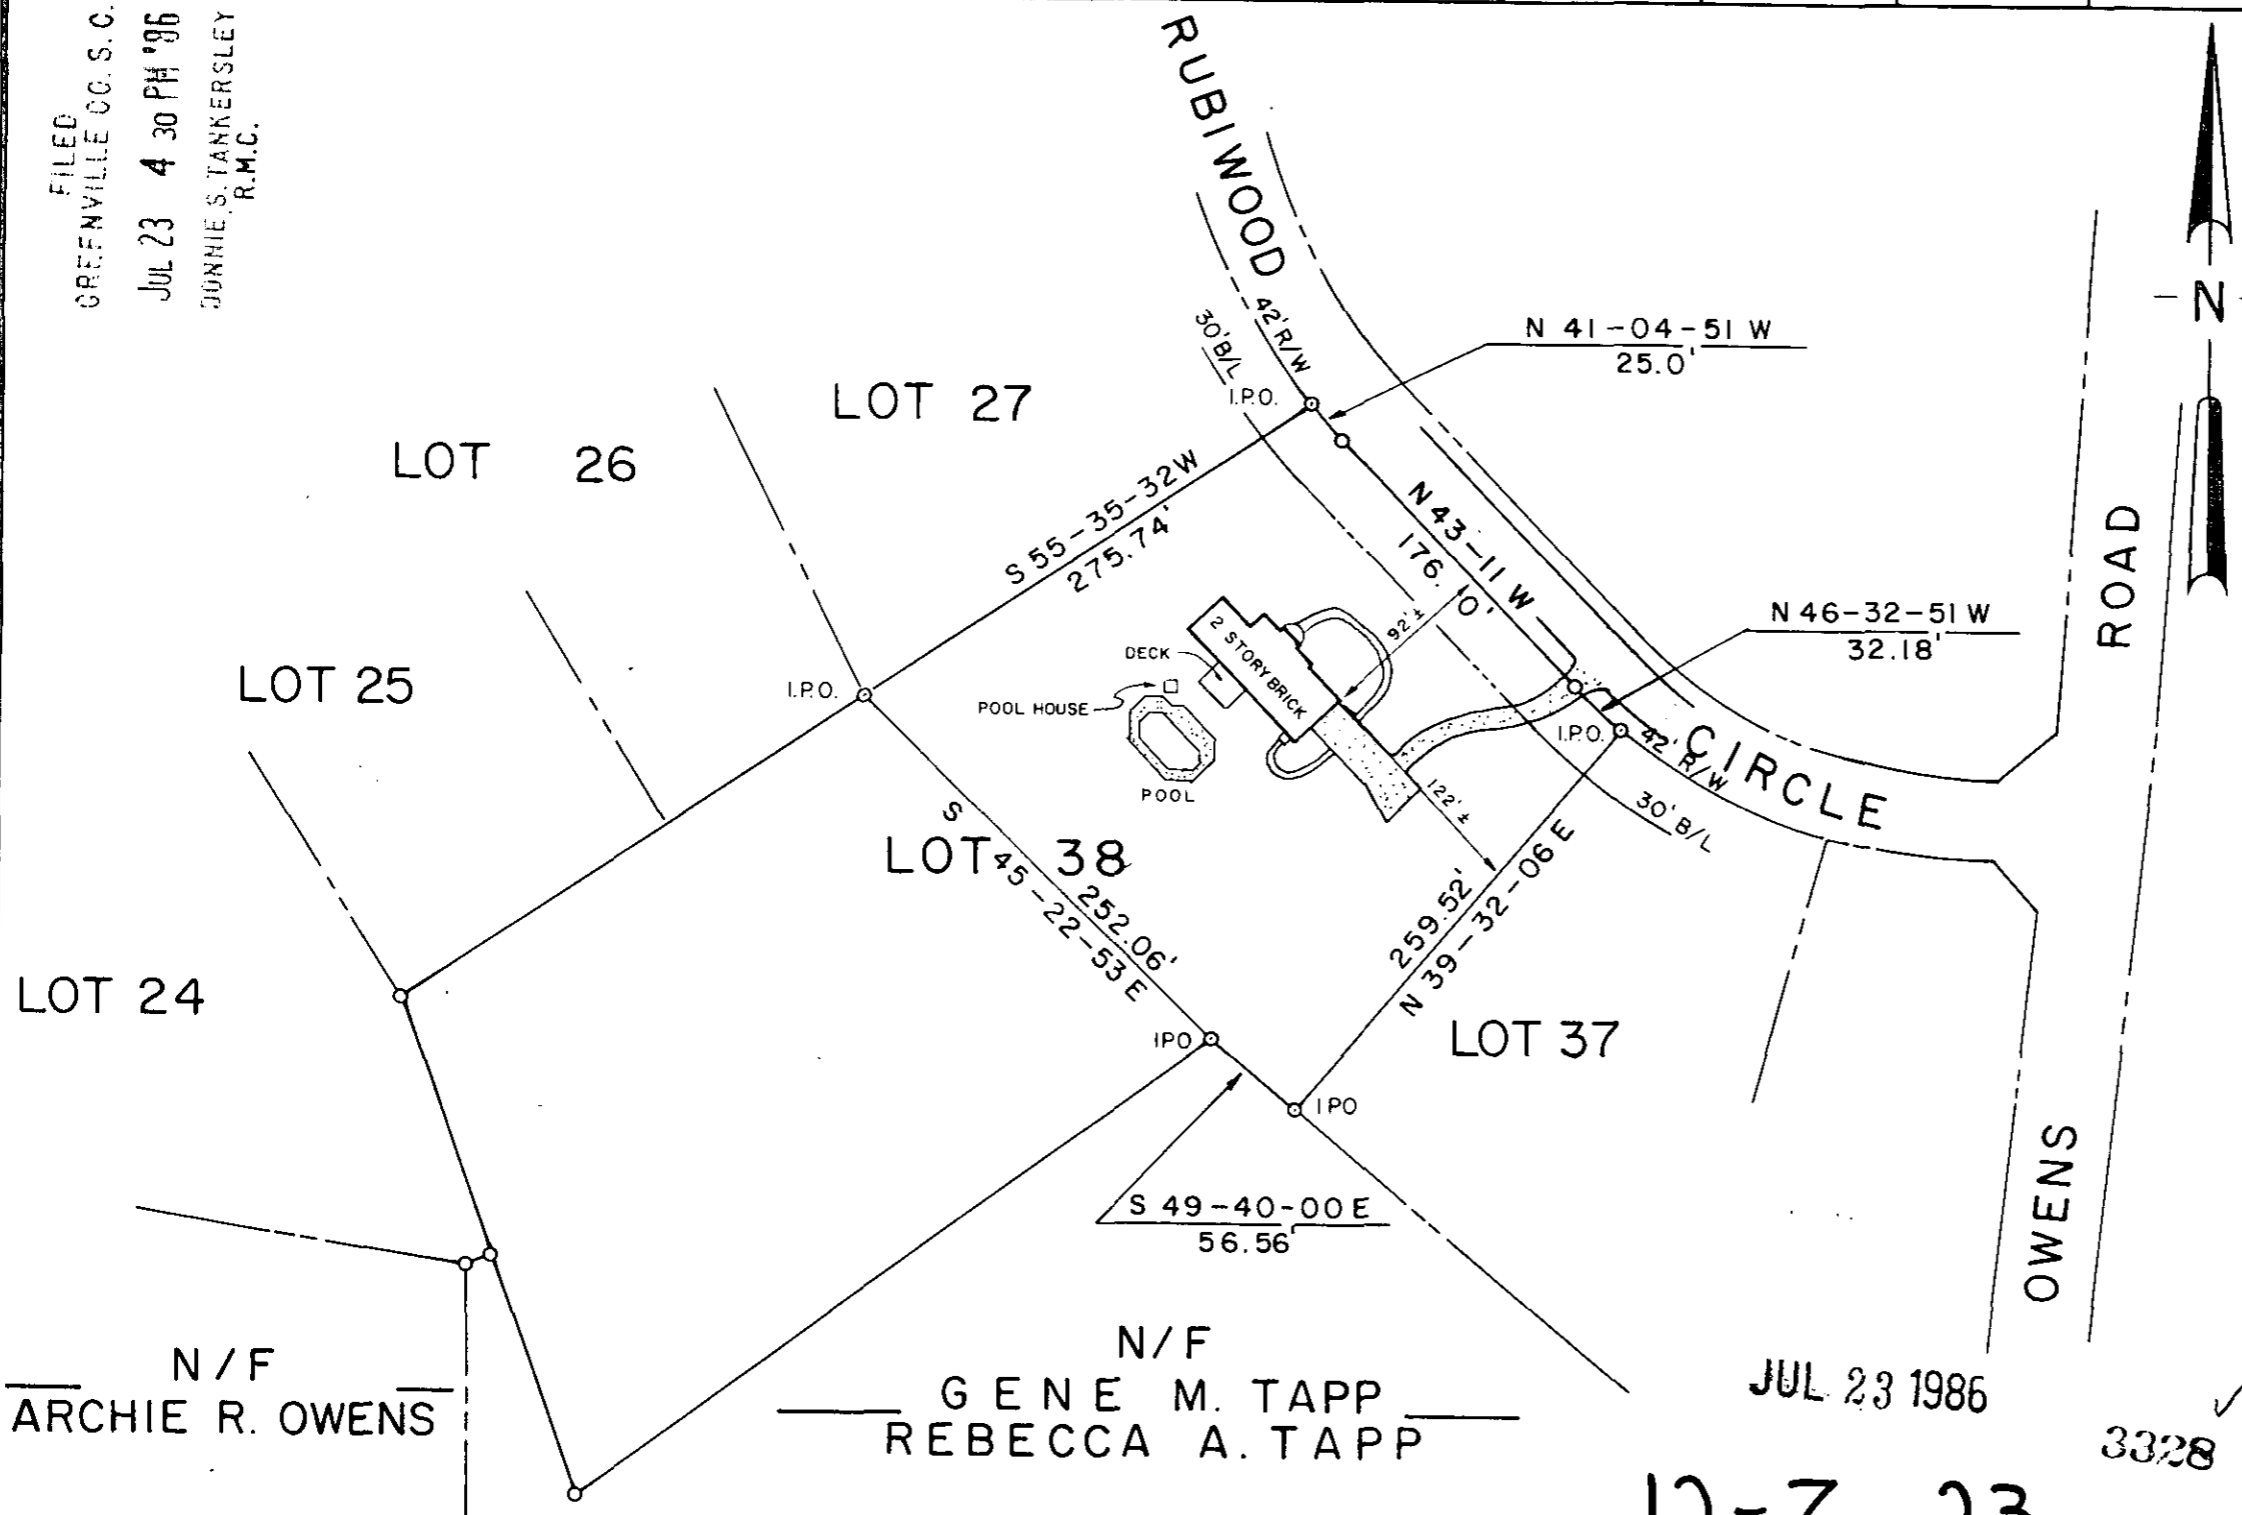

MAGNETIC

CERTIFICATION

DALE A. VAN SLOOTEN & KAY A. VAN SLOOTEN
THIS IS TO CERTIFY TO KAY A. VAN SLOOTEN THAT AN ACTUAL FIELD SURVEY WAS PERFORMED ON THIS PROPERTY UNDER MY SUPERVISION AND I DECLARE THAT:
(1) THE FIELD SURVEY AND THIS PLAT REPRESENT A DEPENDENT RESURVEY OF THE SUBJECT PROPERTY AND THAT THE INFORMATION SHOWN HEREON IS CORRECT TO THE BEST OF MY PROFESSIONAL KNOWLEDGE AND BELIEF
(2) ALL RIGHTS OF WAY, EASEMENTS AND ENCROACHMENTS, OBVIOUS AND APPARENT FROM FIELD OBSERVATION OF THE SUBJECT PROPERTY AT THE TIME OF THE SURVEY ARE AS SHOWN.
(3) THE AREA OF THE SUBJECT PROPERTY WAS CALCULATED BY COORDINATES AND THAT THIS IS A CLASS B SURVEY.

Thomas A. Garrett 7/16/86 8812
SIGNATURE OF REGISTERED LAND SURVEYOR, DATE, S.C. REG. NO.

THIS IS TO CERTIFY TO _____ THAT THIS DRAWING IS A COMPOSITE PLAT AND DOES NOT CONSTITUTE AN ACTUAL FIELD SURVEY, AND THAT ANY USE OF THIS DRAWING FOR ANY PURPOSE OTHER THAN GENERAL REFERENCE IS DONE SO WITH THE UNDERSTANDING THAT ARBOR ENGINEERING INC. ASSUMES NO RESPONSIBILITY OR LIABILITY FOR ITS ACCURACY OR CORRECTNESS.

SIGNATURE OF REGISTERED LAND SURVEYOR _____ DATE _____ S.C. REG. NO. _____

THE DEPARTMENT OF HOUSING AND URBAN DEVELOPMENT FLOOD WAY DATA FOR GREENVILLE COUNTY SHOWS THIS PROPERTY TO BE IN A FLOOD PLAIN AREA NOT TO BE IN A FLOOD PLAIN AREA
 LOCATION CANNOT BE DETERMINED.
THIS PLAT DOES NOT CONSTITUTE OR WARRANT COMPLIANCE OR NON-COMPLIANCE WITH ANY ZONING OR BUILDING REGULATION, MUNICIPAL ORDINANCE OR SUBDIVISION REGULATION UNLESS SPECIFICALLY STATED ELSEWHERE ON THIS DRAWING.

**PROPERTY SURVEY FOR
DALE A. VAN SLOOTEN
& KAY A. VAN SLOOTEN**
A PORTION OF LOT NO. 38
MOUNTAIN MEADOWS SUBDIVISION
GREENVILLE SOUTH CAROLINA

SCALE 100 0 100 200

RESEARCH IAR	DRAWN WNS	CHECK TAG	DATE 14 JULY 86
FILE	FIELD WORK BY IAR-BES	JOB NO. 86175	

ARBOR ENGINEERING
P.O. BOX 263, GREENVILLE, S.C.
LANDSCAPE ARCHITECTS-ENGINEERS-LAND SURVEYORS

N/F
ARCHIE R. OWENS

N/F
GENE M. TAPP
REBECCA A. TAPP

JUL 23 1986

12-Z-23

3328