
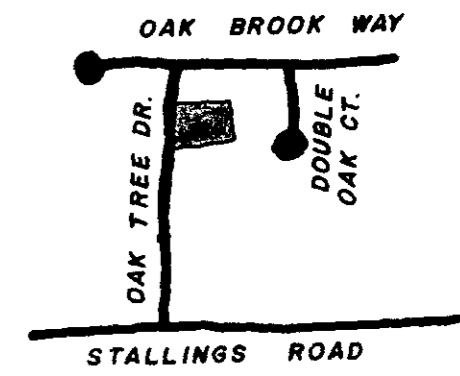


FILED
 GREENVILLE CO. S. C.
 AUG 18 11 36 AM '86
 DONNIE S. TANKERSLEY
 R.M.C.

OAK TREE DRIVE

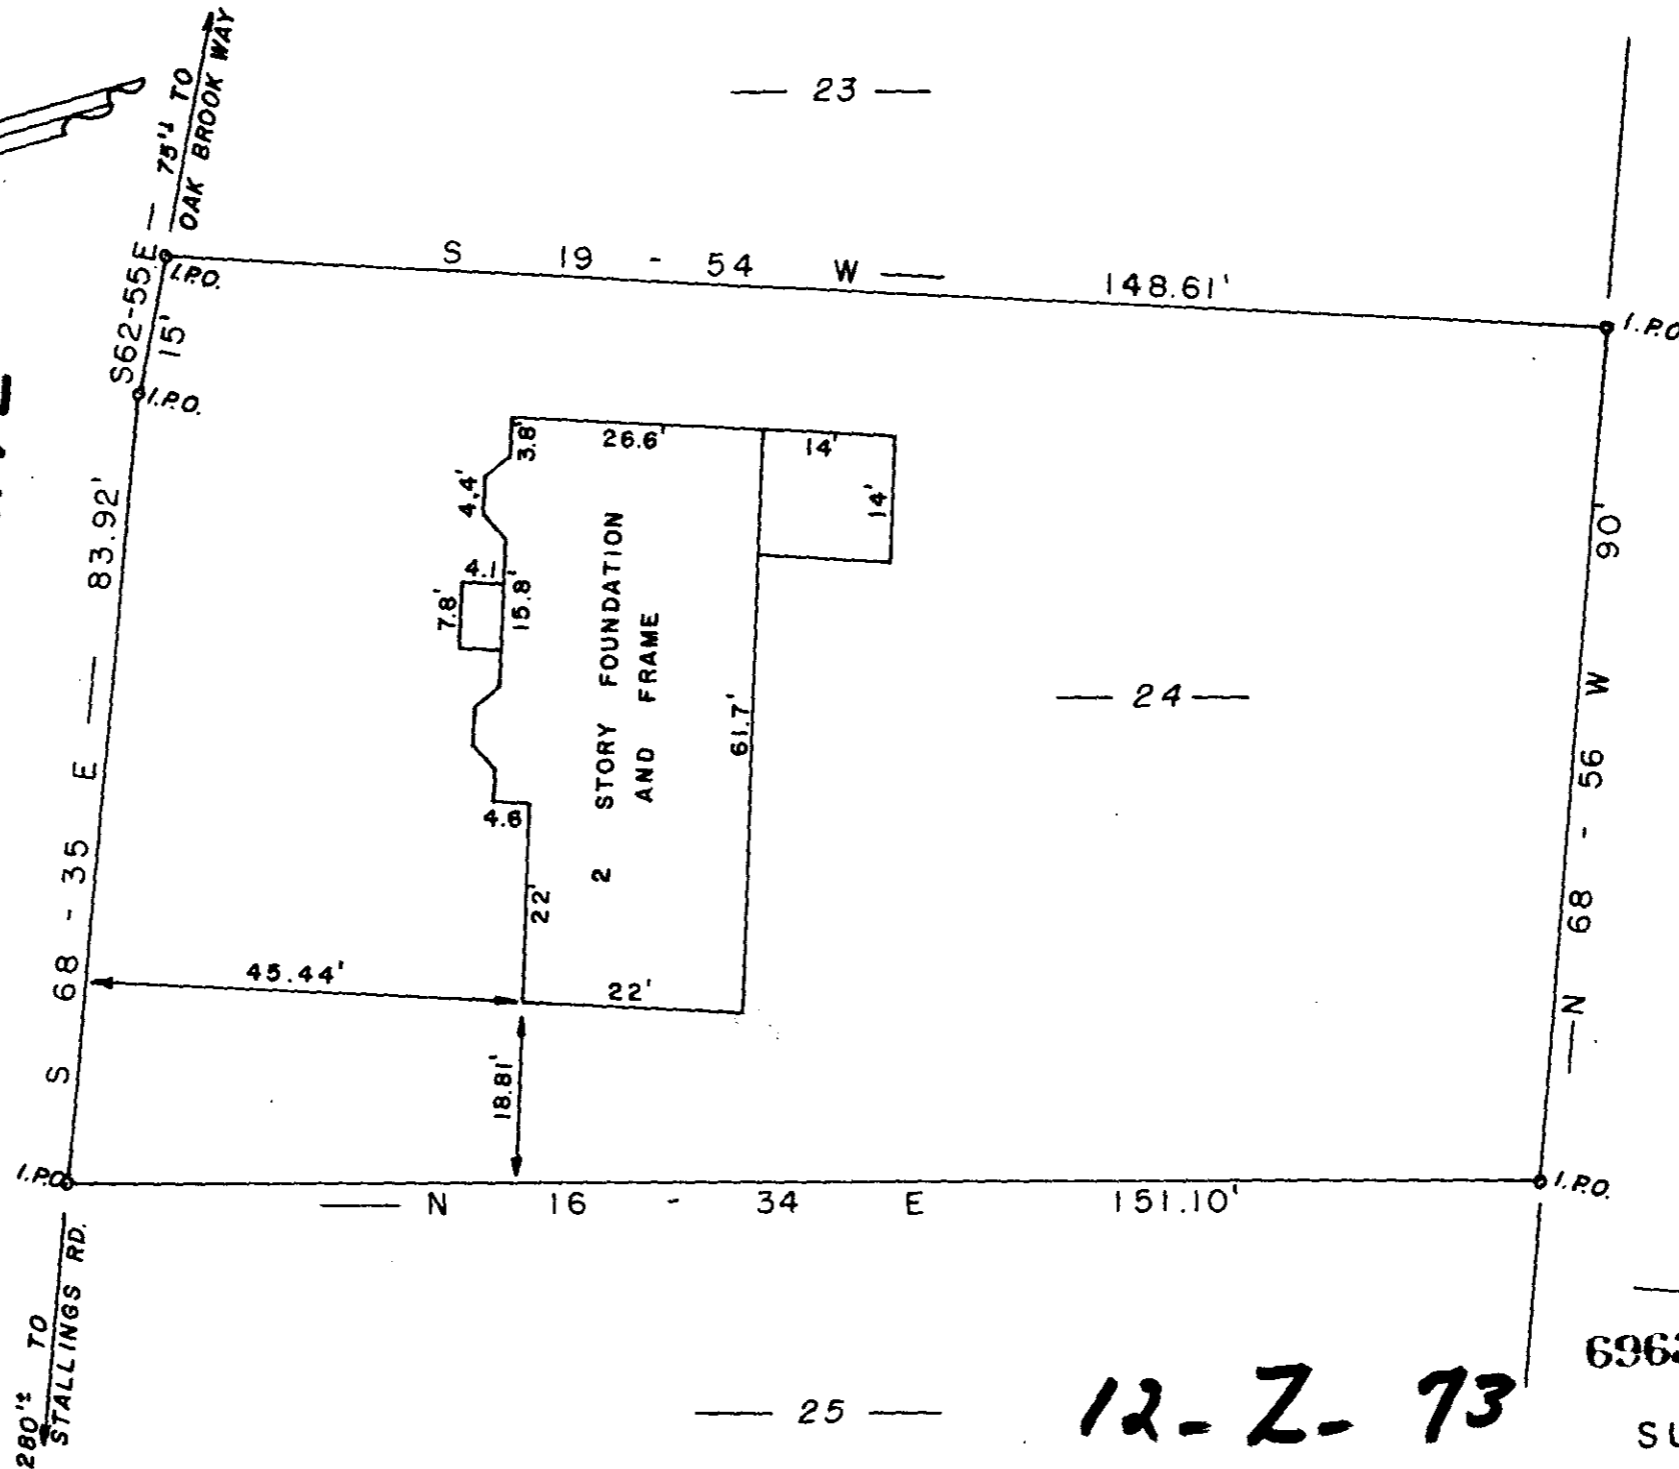

12-2-73

6963

SURVEY FOR

GABRIEL BUILDERS, INC.
 GREENVILLE CO. SOUTH CAROLINA

WEBB SURVEYING & MAPPING GROUP
 P.O. BOX 4756 - 29608

20 0 20 40
 SCALE 1" = 20 FT.
 DATE AUG. 1986

AUG 18 1986

REF. PLAT BOOK 11-I PAGE 98
 B.B.R. P25.3 - 1-58

- I HEREBY CERTIFY THE RATIO OF PERECSON OF THE FIELD SURVEY IS 1/ 8000 THE AREA WAS DETERMINED BY D.M.D. CALCULATION
- I HEREBY CERTIFY THAT THE PROPERTY LINES AND ANY IMPROVMENTS ARE CORRECT AND NO VISIBLE ENCROACHMENTS EXIST UNLESS OTHERWISE SHOWN
- THIS PROPERTY IS SUBJECT TO ANY EASEMENTS OR RIGHT OFWAYS OF RECORD OR NOT OF RECORD
- THIS PRO. IS NOT WITHIN A FLOOD HAZARD AREA

Charles J. Webb
 CHARLES F. WEBB
 REGISTERED
 1977
 LAND SURVEYOR
 SOUTH CAROLINA

THE PRINT MACHINE, INC. #72651

MICROFILMED