


FINAL PLAN APPROVED
 GREENVILLE CITY PLANNING & ZONING COMMISSION
 DATE 2/14/64 BY *J. B. Bates*
 SECRETARY OF COMMISSION

FILED
 GREENVILLE CO. S. C.
 FEB 14 3 14 PM 1964

OLLIE FARNSWORTH
 R. M. O.

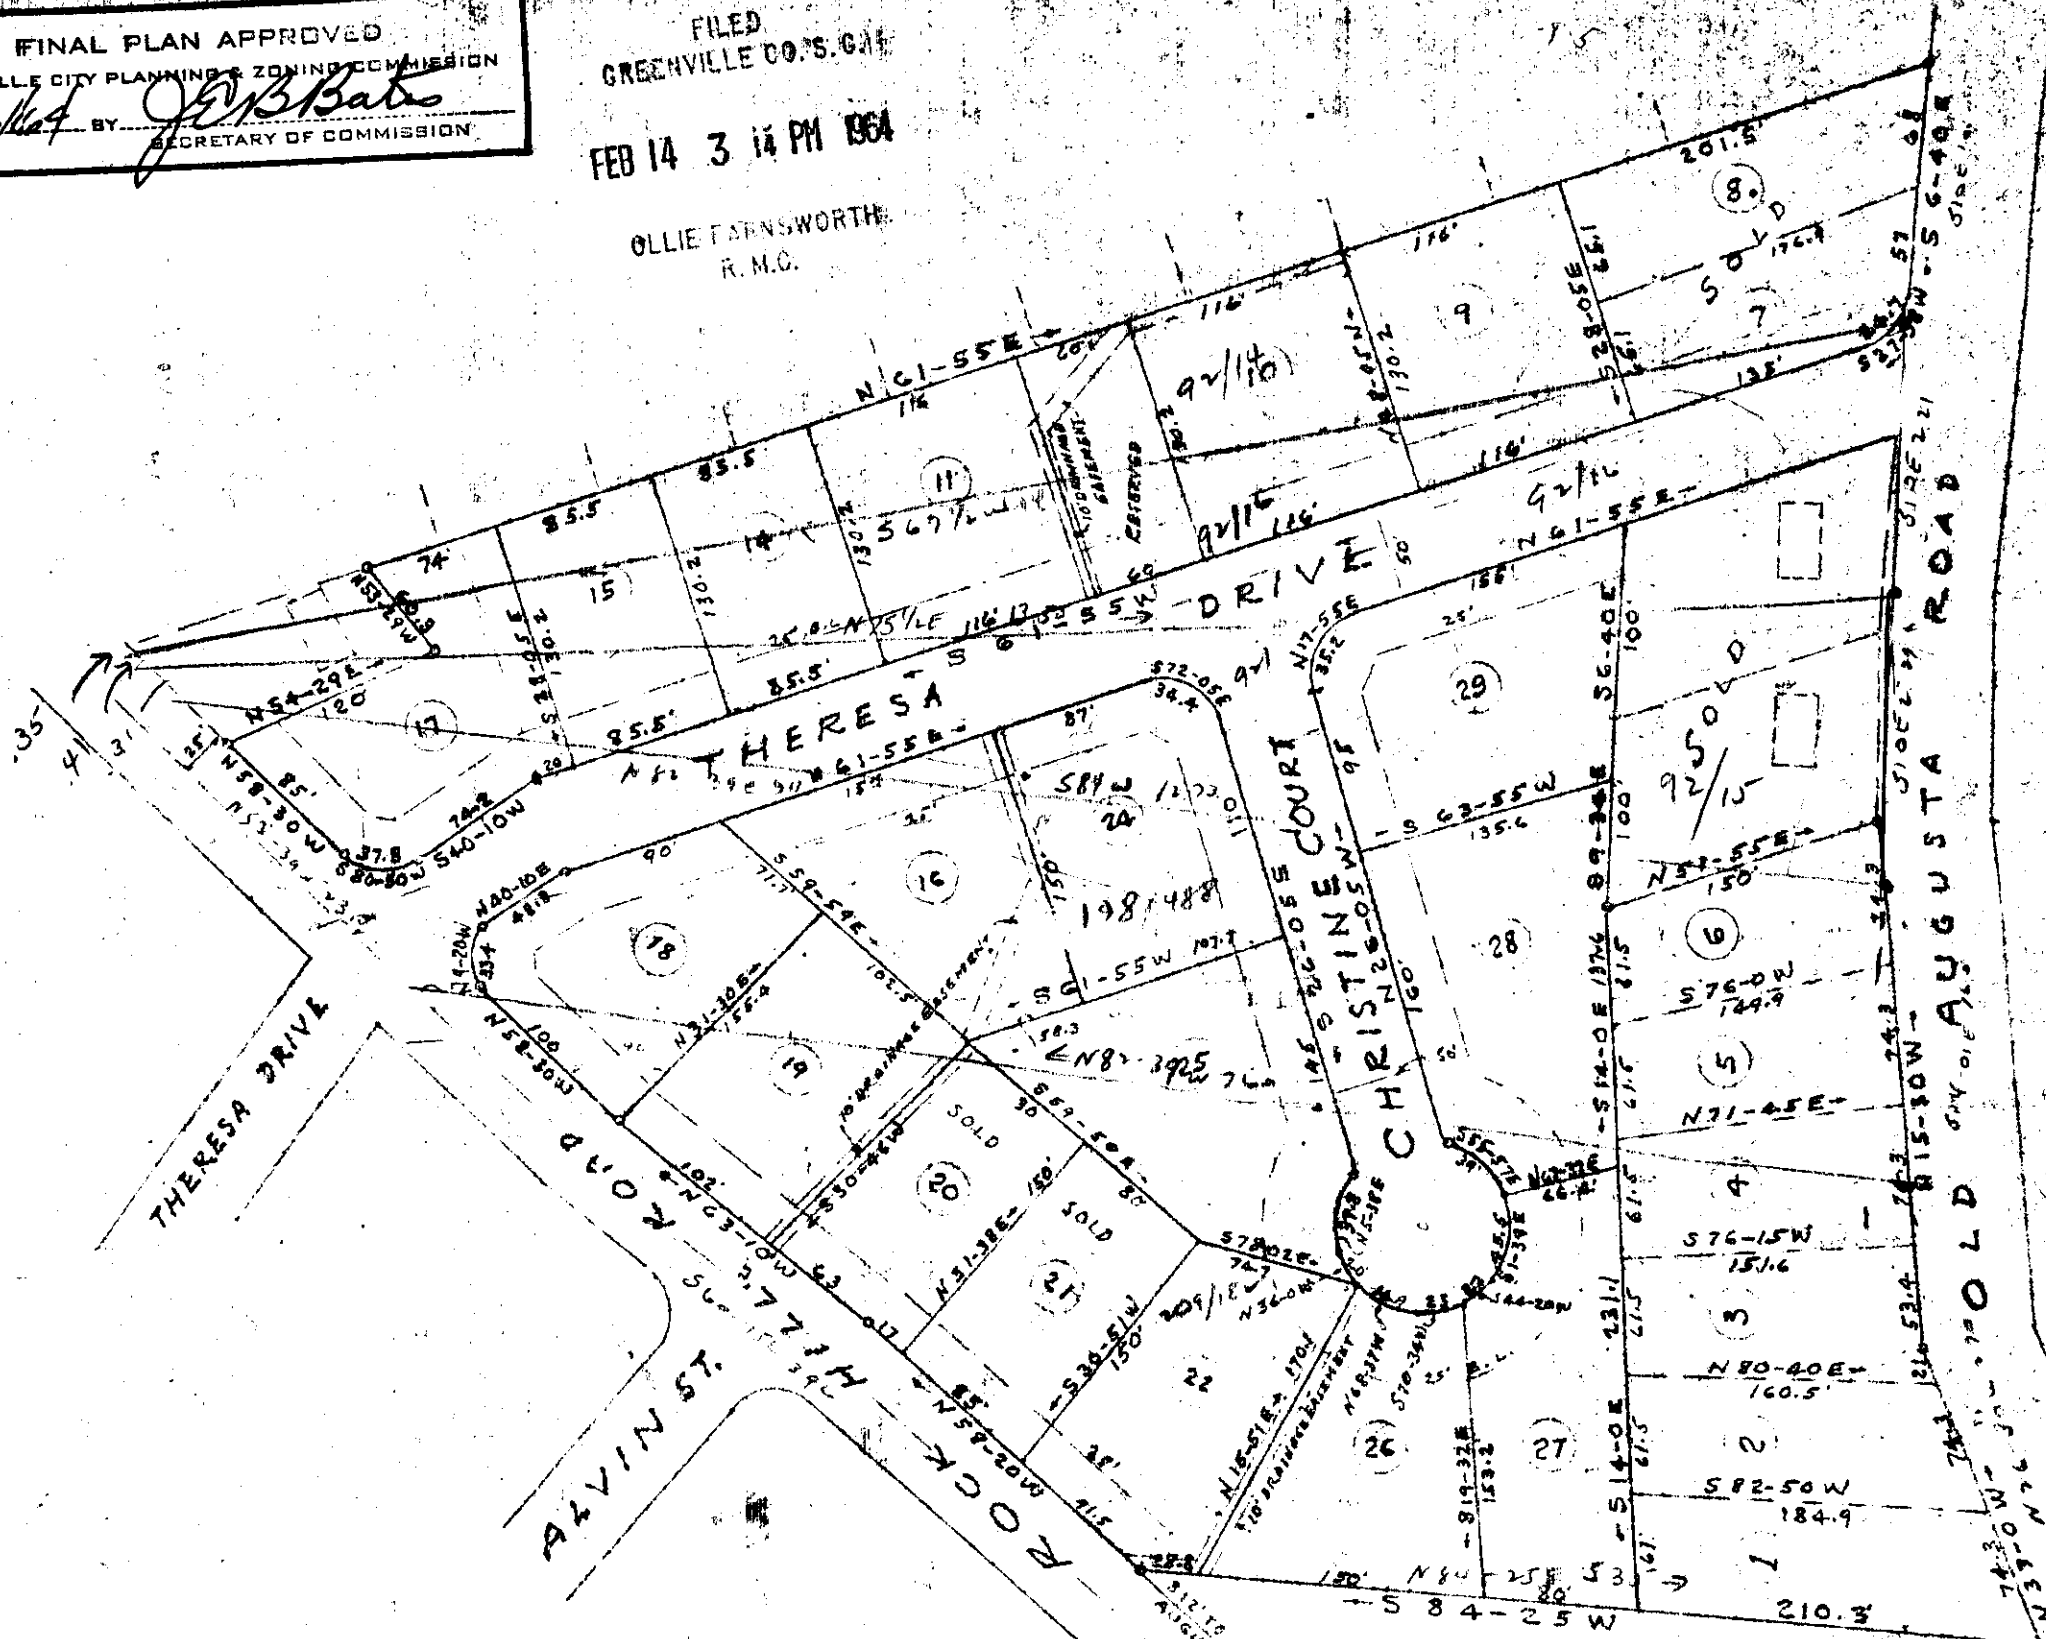

NOTE: LOT Nos. 12, 13, 28 & 30
 HAS BEEN DELETED

REVISED
 FINAL PLAT
 DREHER COLONY
 NEAR GREENVILLE S.C.
 1"=100' JANUARY 1964

CERTIFICATE OF OWNER

THIS IS TO CERTIFY THAT I AM THE OWNER
 OF PROPERTY SHOWN ON THIS PLAT AND
 DO APPROVE OF THE SUBDIVISION THEREOF
 AS SHOWN

SIGNED *Marie Dreher*

Paste in 100

FFF-41

CERTIFICATE OF SURVEY

I HEREBY CERTIFY THAT THIS IS AN
 ACCURATE MAP OF AN ACTUAL SURVEY
 COMPLETED BY ME JAN. 31, 1964
R. C. Campbell & H. C. Clark
 REG. L.S. No. 976 & 2589

FEB 14 1964

23063

110-A

23063 Filed This 14 day of Feb. 1964
 And Recorded in Vol. FFF Page 41 at M
Marie Dreher
 Register Mesne Conveyance Greenville County, S. C.